TOTAL SHEETS = 110


PLUMBING

CONSTRUCTION PLANS

LARGE AIRCRAFT STORAGE HANGAR 405 JIM KLICK DRIVE ROMEOVILLE, ILLINOIS


JOLIET REGIONAL PORT DISTRICT LEWIS UNIVERSITY AIRPORT (LOT) ROMEOVILLE, WILL COUNTY, ILLINOIS

PERMIT REVISIONS JUNE 6, 2025

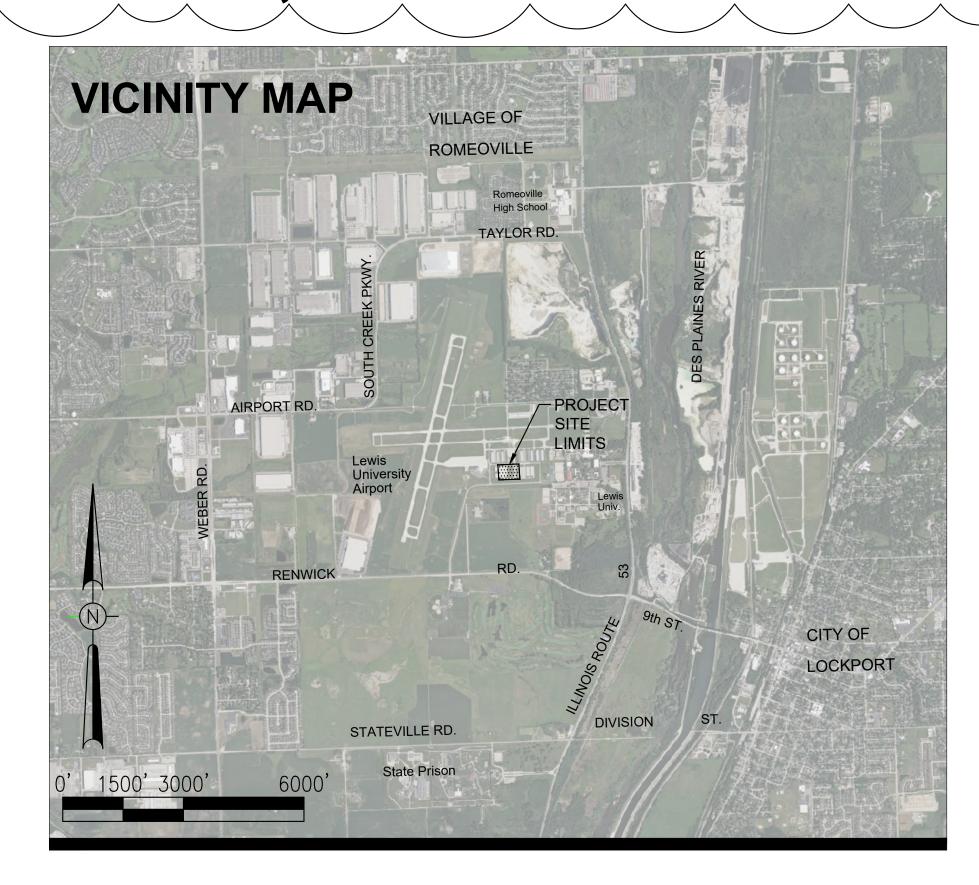

NOTICE TO CONTRACTORS AND BIDDERS


THESE CONSTRUCTION PLANS RELY UPON THE SPECIAL PROVISIONS AND THE SPECIFICATIONS TO PROVIDE FOR A COMPLETE DESCRIPTION OF THE WORK AND CONSTRUCTION REQUIREMENTS. THE PLANS SHALL ONLY BE USED IN COMBINATION WITH ALL CONTRACT DOCUMENTS.

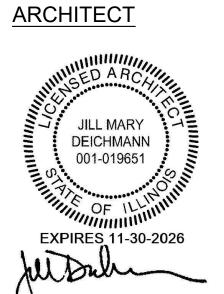


FIRE PROTECTION

062-065192 LICENSED PROFESSIONAL ENGINEER


5/2/2025

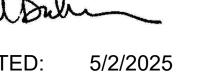

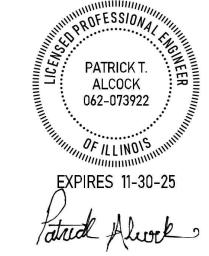

ELECTRICAL



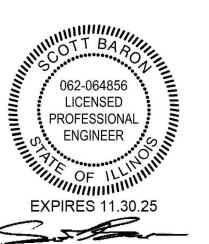

<u>CIVIL</u>



STRUCTURAL




MECHANICAL



| 3 | PERMIT REVISIONS | | 06/06/2025 | RH |
|-----|-------------------|----------------|------------|----|
| 2 | PERMIT REVISIONS | | 05/02/2025 | RH |
| 1 | BID ADDENDA | | 05/02/2025 | RH |
| No. | Issue/Description | Sheets Changed | Date | Ву |





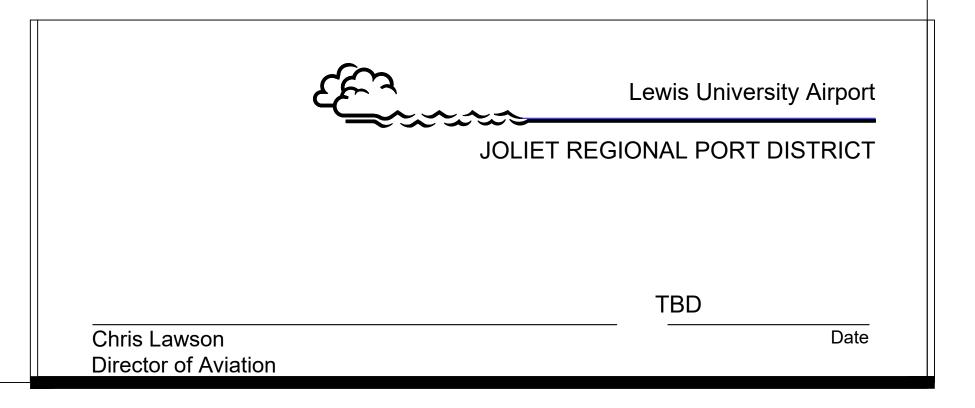

| | INDEX OF SHEETS |
|--------------|---|
| HEET NO. | TITLE |
| MECHANIC | CAL |
| M000 | MECHANICAL NOTES |
| M100 | MECHANICAL - FIRST FLOOR PLAN OVERALL |
| M101 | MECHANICAL - FIRST FLOOR PLAN NORTH |
| M102 | MECHANICAL - FIRST FLOOR PLAN SOUTH |
| M103 | MECHANICAL - FIRST FLOOR PLAN BACK OF HOUSE |
| M110 | MECHANICAL - ROOF FLOOR PLAN OVERALL |
| M113 | MECHANICAL - ROOF FLOOR PLAN BACK OF HOUSE |
| M500 | MECHANICAL - DETAILS |
| M501 | MECHANICAL - DETAILS |
| M600 | MECHANICAL - SCHEDULES |
| M700 | TEMPERATURE CONTROLS |
| PLUMBING | G |
| P000 | PLUMBING NOTES, SYMBOLS AND ABBREVIATIONS |
| P111 | PLUMBING WATER - FIRST FLOOR PLAN NORTH |
| P112 | PLUMBING WATER - FIRST FLOOR PLAN SOUTH |
| P201 | PLUMBING SANITARY, VENT AND STORM - UNDERGROUND PLAN NORTH |
| P202 | PLUMBING SANITARY, VENT AND STORM - UNDERGROUND PLAN SOUTH |
| P211 | PLUMBING SANITARY, VENT AND STORM - GINDERGROUND PLAN SOUTH PLUMBING SANITARY, VENT AND STORM - FIRST FLOOR PLAN NORTH |
| P211 | PLUMBING SANITARY, VENT AND STORM - FIRST FLOOR PLAN NORTH PLUMBING SANITARY, VENT AND STORM - FIRST FLOOR PLAN SOUTH |
| P212 P221 | |
| | PLUMBING SANITARY, VENT AND STORM - ROOF FLOOR PLAN NORTH |
| P222 | PLUMBING SANITARY, VENT AND STORM - ROOF FLOOR PLAN SOUTH |
| P400 | PLUMBING SCHEDULES |
| P500 | PLUMBING DETAILS |
| FIRE PRO | |
| F000 | FIRE PROTECTION NOTES, SYMBOLS AND ABBREVIATIONS SCHEDULES |
| F100 | FIRE PROTECTION - OVERALL FLOOR PLAN |
| F101 | FIRE PROTECTION - FIRST FLOOR PLAN NORTH |
| F102 | FIRE PROTECTION - FIRST FLOOR PLAN SOUTH |
| F103 | FIRE PROTECTION - FLOOR PLAN BACK OF HOUSE |
| F200 | FIRE PROTECTION - OVERALL REFLECTED CEILING PLAN |
| F201 | FIRE PROTECTION - FIRST FLOOR REFLECTED CEILING PLAN NORTH |
| F202 | FIRE PROTECTION - FIRST FLOOR REFLECTED CEILING PLAN SOUTH |
| F203 | FIRE PROTECTION - REFLECTED CEILING PLAN BACK OF HOUSE |
| F400 | FIRE PROTECTION - RISER DIAGRAM |
| F500 | FIRE PROTECTION - DETAILS |
| ELECTRIC | ;AL |
| E000 | ELECTRICAL SYMBOLS AND ABBREVIATIONS |
| E001 | ELECTRICAL CALCULATIONS AND GENERAL NOTES |
| E002 | ELECTRICAL SITE PLAN |
| E100 | ELECTRICAL LIGHTING - FIRST FLOOR OVERALL RCP |
| E101 | ELECTRICAL LIGHTING - FIRST FLOOR RCP NORTH |
| E102 | ELECTRICAL LIGHTING - FIRST FLOOR RCP SOUTH |
| E103 | ELECTRICAL LIGHTING - FIRST FLOOR RCP BACK OF HOUSE |
| E200 | ELECTRICAL POWER AND SYSTEMS - FIRST FLOOR PLAN OVERALL |
| E201 | ELECTRICAL POWER AND SYSTEMS - FIRST FLOOR PLAN NORTH |
| E202 | ELECTRICAL POWER AND SYSTEMS - FIRST FLOOR PLAN SOUTH |
| E203 | ELECTRICAL POWER AND SYSTEMS - FIRST FLOOR PLAN BACK OF HOUSE |
| | ELECTRICAL POWER AND SYSTEMS - FIRST FLOOR PLAN BACK OF HOUSE ELECTRICAL RISER DIAGRAM |
| E400 | |
| E500 | ELECTRICAL SCHEDULES |
| E501 | PANEL SCHEDULES - NORMAL |
| | PANEL SCHEDULES - EMERGENCY |
| E502 | |
| E502 E503 | LIGHTING CONTROLS SCHEDULE |









LARGE AIRCRAFT STORAGE HANGAR 405 JIM CLICK DRIVE ROMEOVILLE, ILLINOIS

| _3_ | PERMIT REVISIONS | | | 06/06/25 |
|------|------------------|----|-----------|----------|
| _2_ | PERMIT REVISIONS | | | 05/02/25 |
| 1 | BID ADDENDA | | | 05/02/25 |
| No. | Description | Ву | Chk. App. | Date |
| Issu | ies | | | |

DRAWING TITLE

INDEX OF DRAWINGS

APPROVED
RMH
CHECKED

SHEET NO.

VS____

G002

DRAWN BY

JVJ

/ED DATE PRINTED PRIN

ALL TAXIWAYS WITHIN THE PROJECT LIMITS ARE FAA CATEGORY II.



J.U.L.I.E. JOINT UTILITY LOCATING INFORMATION FOR EXCAVATORS www.illinois1call.com

THE LOCATION. SIZE AND TYPE OF MATERIAL OF EXISTING UNDERGROUND ACCURATE, SUFFICIENT OR COMPLETE IT SHALL BE THE CONTRACTOR'S RESPONSIBILITY TO DETERMINE ACTUAL LOCATIONS OF ALL SUCH FACILITIES, INCLUDING SERVICE CONNECTIONS TO UNDERGROUND UTILITIES. PRIOR TO CONSTRUCTION, THE CONTRACTOR SHALL NOTIFY UTILITY COMPANIES OF HIS OPERATIONAL PLANS, OBTAIN FROM RESPECTIVE UTILITY COMPANIES DETAILED INFORMATION AND ASSISTANCE RELATIVE TO THE LOCATION OF THEIR FACILITIES AND THE WORKING SCHEDULE OF THE COMPANIES FOR REMOVAL OR ADJUSTMENT WHERE REQUIRED. IN THE EVENT AN UNEXPECTED UTILITY INTERFERENCE IS ENCOUNTERED DURING CONSTRUCTION, THE CONTRACTOR SHALL IMMEDIATELY NOTIFY THE UTILITY COMPANY OF JURISDICTION AND THE ONE-CALL NOTICE SYSTEM. THE ENGINEER SHALL ALSO BE IMMEDIATELY NOTIFIED. ANY SUCH UTILITY OR SERVICES SHALL BE RESTORED TO SERVICE AT ONCE AND PAID FOR BY THE CONTRACTOR AT NO ADDITIONAL COST TO THE CONTRACT.

CALL J.U.L.I.E. FOR UTILITY INFORMATION AT 811.

1. THE CONTRACTOR SHALL NOT CROSS ANY RUNWAYS OR OTHER ACTIVE AIRFIELD MOVEMENT AREA PAVEMENTS.

2. WORK MUST BE CONTROLLED.

3. MAXIMUM EQUIPMENT HEIGHT SHALL BE 25 FEET AT ALL LOCATIONS, EXCEPT FOR CRANE HEIGHTS OF 175 FEET AND/OR BY PRIOR APPROVAL OF THE ENGINEER, AIRPORT, AND FAA TOWER.

4. TRAFFIC TO BE MAINTAINED ON ALL AIRPORT ROADWAYS AT ALL TIMES EXCEPT AT DESIGNATED WORK AREAS AND TEMPORARY STABILIZED ENTRANCE ROADS.

5. NO CLOSURES TO TAXIWAY, APRON, ROADWAY, AND AUTO PARKING SHALL BE CONDUCTED EXCEPT AS SHOWN IN THE SITE PLAN.

6. THE AIRCRAFT AND GROUND VEHICLE TRAFFIC IS UNDER THE CONTROL OF AN FAA AIRCRAFT CONTROL TOWER. ALL CONTRACTOR ACTIVITY IS SUBJECT TO THIS CONTROL. THE AIRPORT MANAGER OR THEIR REPRESENTATIVE WILL COORDINATE CONTRACTOR ACTIVITIES WITH THE FAA CONTROL TOWER MANAGER. THE CONTRACTOR IS REQUIRED TO GIVE ADVANCE NOTICE OF ANY REQUESTS ON ANY ACTIVE AIRFIELD RUNWAYS OR TAXIWAYS.

AREAS OUTSIDE THE WORK LIMITS THAT ARE DISTURBED OR DAMAGED SHALL BE RESTORED TO ITS EXISTING CONDITIONS AND SHALL NOT BE PAID EXTRA BUT INCLUDED IN THE CONTRACT COST.

EXISTING BENCHMARKS / CONTROL POINTS

PROJECT BENCHMARKS ARE AS FOLLOWS: CUT CROSS ON THE S.E. FIRE HYDRANT

CUT CROSS CP#1 N: 1,798,454.466 E: 1,050,462.191

PROJECT CONTROL POINTS ARE AS FOLLOWS:

ELEV 666.057 SET CUT SQUARE ON E. SIDE ON BM#2 CONC. BASE FOR TALL LIGHT POLE ELEV 666.419

BM#1 FLANGE BOLT

SET 5/8" REBAR W/ CAP CP#2 N: 1,798,860.868 E: 1,050,453.755

SET CUT SQUARE ON THE S.E. CORNER BM#3 OF CONC. PAD FOR JET FUEL CABINET ELEV 665.849

CUT CROSS ON THE S.E. FIRE HYDRANT

CP#3 N: 1,798,855.476 E: 1,051,081.297 SET 5/8" REBAR W/ CAP

SET 5/8" REBAR W/ CAP

BM#4 FLANGE BOLT CP#4 N: 1,798,367.911 ELEV 664.79 E: 1,051.023.434 COORDINATES ARE REFERENCED TO THE ILLINOIS STATE PLANE

COORDINATE SYSTEM, EAST ZONE, NAD83(2011), ELEVATIONS SHOWN ARE REFERENCED TO NAVD88 DATUM. CONTROL POINTS AND BENCHMARKS SHALL BE VERIFIED AND TIED TO THE WILL COUNTY

GENERAL NOTES

PROJECT DESCRIPTION

THIS PROJECT IS TO CONSTRUCT A NEW LARGE AIRCRAFT STORAGE HANGAR AND ASSOCIATED PAVEMENT AND UTILITY CONSTRUCTION. THIS WORK INCLUDES:

- PLACEMENT OF TEMPORARY EROSION CONTROL MEASURES.
- CONSTRUCTION OF A NEW LARGE AIRCRAFT STORAGE HANGAR (APPROX. 40,000
- SQUARE FEET).
- CONSTRUCTION OF NEW FIRE EQUIPMENT ACCESS PAVEMENT AND DRIVEWAY.
- UTILITY CONNECTIONS TO HANGAR INCLUDING ELECTRIC, DOMESTIC/FIRE WATER

EXTEND AIRCRAFT APRON WITH NEW PORTLAND CEMENT CONCRETE PAVEMENT.

MAIN, MUNICIPAL SANITARY SEWER, AND NATURAL GAS SERVICE.

- CONSTRUCT NEW SIDEWALK
- INSTALL TEMPORARY/PERMANENT EROSION CONTROL AND LANDSCAPING.

PROTECTION OF EXISTING AIRPORT FACILITIES

THE CONTRACTOR IS TO BE RESPONSIBLE FOR THE PROTECTION OF EXISTING UNDERGROUND AND OVERHEAD UTILITIES AND LIGHTING EQUIPMENT; DRIVEWAY AND ROAD PAVEMENT AND SHOULDERS; RUNWAY, TAXIWAY AND APRON PAVEMENTS AND SHOULDERS; RUNWAY, TAXIWAY AND AIRPORT LIGHTING EQUIPMENT; AND SEEDED AND TURFED AREAS THAT ARE UTILIZED IN OR AFFECTED BY THE CONTRACTOR'S ACTIVITIES. ITEMS DAMAGED BY THE CONTRACTOR ARE TO BE REPAIRED AT CONTRACTOR'S EXPENSE AND TO THE SATISFACTION OF AIRPORT MANAGER AND THE OWNER'S REPRESENTATIVE.

IN ADDITION, WHEN CONDITIONS DICTATE OR AS DETERMINED BY THE AIRPORT MANAGER OR THE OWNER'S REPRESENTATIVE, THE CONTRACTOR SHALL BE REQUIRED TO USE A PICK-UP TYPE SWEEPER IN ALL ACTIVE CONSTRUCTION AIRFIELD PAVEMENT AREAS. THE CONTRACTOR WILL BE REQUIRED TO HAVE A SWEEPER AVAILABLE FOR USE AT ALL TIMES. THE COST OF SWEEPING SHALL BE CONSIDERED INCIDENTAL TO THE CONTRACT.

THE CONTRACTOR SHALL BE RESPONSIBLE FOR CONTACTING THE FAA (SMO) THROUGH THE CONSTRUCTION MANAGER TO LOCATE ALL FAA CABLES ON THE PROJECT SITE. ALL FAA CABLES SHALL BE PROTECTED AT ALL TIMES. NO FAA CABLING HAS BEEN IDENTIFIED WITHIN THE PROJECT LIMITS.

CONTRACTOR'S ACCESS AND TEMPORARY FACILITIES

CONTRACTOR'S ACCESS TO THE PROJECT WHEN ON AIRPORT PROPERTY IS SHOWN ON THIS SHEET. CONTRACTOR'S ACCESS TO THE AIRPORT ITSELF IS TO BE PROVIDED BY PUBLIC RIGHTS-OF-WAY. THE CONTRACTOR IS TO SECURE ALL NECESSARY PERMITS FOR THE USE OF ANY PUBLIC RIGHTS-OF-WAY AND IS TO MAINTAIN TRAFFIC ON THESE PUBLIC ROADS AT ALL TIMES, WITH THE COSTS OF PERMITTING, CLEANING AND REPAIRING OF PAVEMENT DAMAGED BY CONTRACTOR'S ACTIVITIES INCIDENTAL TO THE CONTRACT. USE OF AND REPAIRS TO ANY PUBLIC FACILITIES ARE TO BE COMPLETED TO THE SATISFACTION OF THE FACILITY'S OWNER.

HEAVY VEHICLES SHALL NOT CROSS EXISTING PAVEMENT SURFACES EXCEPT AS APPROVED BY THE AIRPORT MANAGER AND THE OWNER'S REPRESENTATIVE. ANY DAMAGE TO PAVEMENTS THAT MAY OCCUR BY THE CONTRACTOR'S ACTIVITIES SHALL BE REPAIRED AT THE CONTRACTOR'S EXPENSE AND TO THE SATISFACTION OF THE AIRPORT MANAGER AND THE OWNER'S REPRESENTATIVE.

THE CONTRACTOR IS TO PROVIDE EQUIPMENT, STORAGE AND PARKING AREA AT THE LOCATION SHOWN ON THIS SHEET. IT IS THE CONTRACTOR'S RESPONSIBILITY TO MAINTAIN THE ACCESS ROADS AND THE STORAGE AREA DURING CONSTRUCTION AND TO RESTORE THE AREAS AT PROJECT COMPLETION TO CONDITIONS SUITABLE TO THE AIRPORT MANAGER AND THE OWNER'S REPRESENTATIVE. AT THE AIRPORT MANAGER'S DISCRETION, THE TEMPORARY FACILITIES MAY REMAIN, BUT THEY MUST BE LEFT IN CONDITIONS SUITABLE TO THE AIRPORT MANAGER. THE COST OF PROVIDING, MAINTAINING AND RESTORING THE TEMPORARY FACILITIES IS INCIDENTAL TO THE CONTRACT.

RESPONSIBILITY FOR EXISTING UTILITIES

THE LOCATION, SIZE AND/OR TYPE OF MATERIAL OF EXISTING UNDERGROUND OR OVERHEAD UTILITIES AS MAY BE INDICATED ON THESE CONSTRUCTION PLANS IS NOT REPRESENTED AS BEING ACCURATE, SUFFICIENT OR COMPLETE. NEITHER THE OWNER NOR THE PROJECT ENGINEER HAVE INDEPENDENTLY VERIFIED THIS INFORMATION AND NEITHER ASSUMES ANY RESPONSIBILITY WHATSOEVER IN RESPECT TO THE ACCURACY, SUFFICIENCY OR COMPLETENESS OF THE INFORMATION AND GIVE NO EXPRESSED OR IMPLIED GUARANTEE THAT ANY CONDITIONS INDICATED ARE REPRESENTATIVE OF ACTUAL CONDITIONS TO BE ENCOUNTERED.

IT SHALL BE THE CONTRACTOR'S RESPONSIBILITY TO DETERMINE THE ACTUAL LOCATION OF ALL SUCH FACILITIES, INCLUDING SERVICE CONNECTIONS TO UNDERGROUND UTILITIES. PRIOR TO CONSTRUCTION, THE CONTRACTOR SHALL NOTIFY ALL UTILITY COMPANIES AND AGENCIES OF HIS CONSTRUCTION PLANS AND SHALL OBTAIN FROM EACH PARTY DETAILED INFORMATION AND ASSISTANCE RELATIVE TO THE LOCATION OF ALL UTILITIES AND THE WORKING SCHEDULE OF ANY REMOVALS OR ADJUSTMENTS REQUIRED OF THE UTILITY. THE CONTRACTOR SHALL CONTACT J.U.L.I.E. (PHONE 800-892-0123) TO ASSIST IN THE ABOVE.

CONTACT THE FAA (FEDERAL AVIATION ADMINISTRATION) FOR ASSISTANCE IN LOCATING FAA CABLES AND UTILITIES. LOCATION OF FAA POWER, CONTROL, AND COMMUNICATION CABLES SHALL BE COORDINATED WITH AND/OR LOCATED BY THE

THE CONTRACTOR SHALL PROTECT ANY FACILITIES TO THE SATISFACTION OF THE UTILITY OR OWNING-AGENCY WITH THE COST OF ANY REQUIRED PROTECTION TO BE INCIDENTAL TO THE CONTRACT. IN THE EVENT A UTILITY LINE OR SERVICE IS UNEXPECTEDLY ENCOUNTERED DURING CONSTRUCTION, THE CONTRACTOR SHALL IMMEDIATELY NOTIFY THE OWNER'S REPRESENTATIVE AND THE UTILITY COMPANY OR AGENCY OF JURISDICTION. ANY SUCH UTILITIES DISTURBED BY THE CONTRACTOR'S OPERATIONS SHALL BE RESTORED TO SERVICE IMMEDIATELY.

AIRPORT SECURITY

THE CONTRACTOR IS TO COORDINATE GATE SECURITY, THROUGH THE CONSTRUCTION MANAGER, WITH THE AIRPORT MANAGEMENT. AIRPORT SECURITY SHALL BE MAINTAINED AT ALL TIMES.

COORDINATION WITH FENCE CONTRACTOR

ALL CONTRACTORS AND SUBCONTRACTORS SHALL COORDINATE THEIR WORTH IN THIS AREA WITH THE CONTRACTOR FOR THE AIRPORT SECURITY FENCE UNDER A SEPARATE CONTRACT.

VILLAGE OF ROMEOVILLE

MR. JONATHON A. ZABROCKI, P.E., C/O VILLAGE OF ROMEOVILLE, 615 ANDERSON DRIVE, ROMEOVILLE, IL 60446, PHONE NUMBER (815) 886-1870)



Lewis University Airport JOLIET REGIONAL PORT DISTRICT






LEWIS UNIVERSITY AIRPORT

LARGE AIRCRAFT STORAGE HANGAR **405 JIM CLICK DRIVE** ROMEOVILLE, ILLINOIS

KEY PLAN

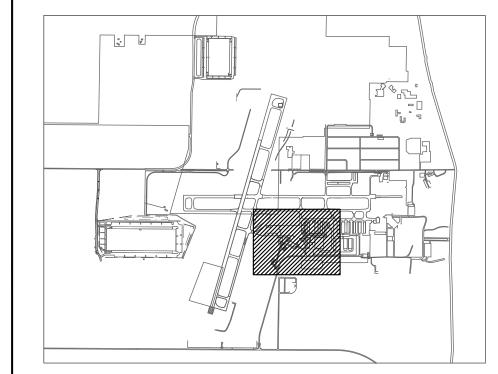

PERMIT REVISIONS PERMIT REVISIONS BID ADDENDA No. Description By Chk. App. Date

PROJECT SITE PLAN,

CONTROL PLAN, AND GENERAL NOTES

APPROVED CHECKED

GI001


SHEET NO.

DRAWN BY JVJ

KWS

Issues

DRAWING TITLE

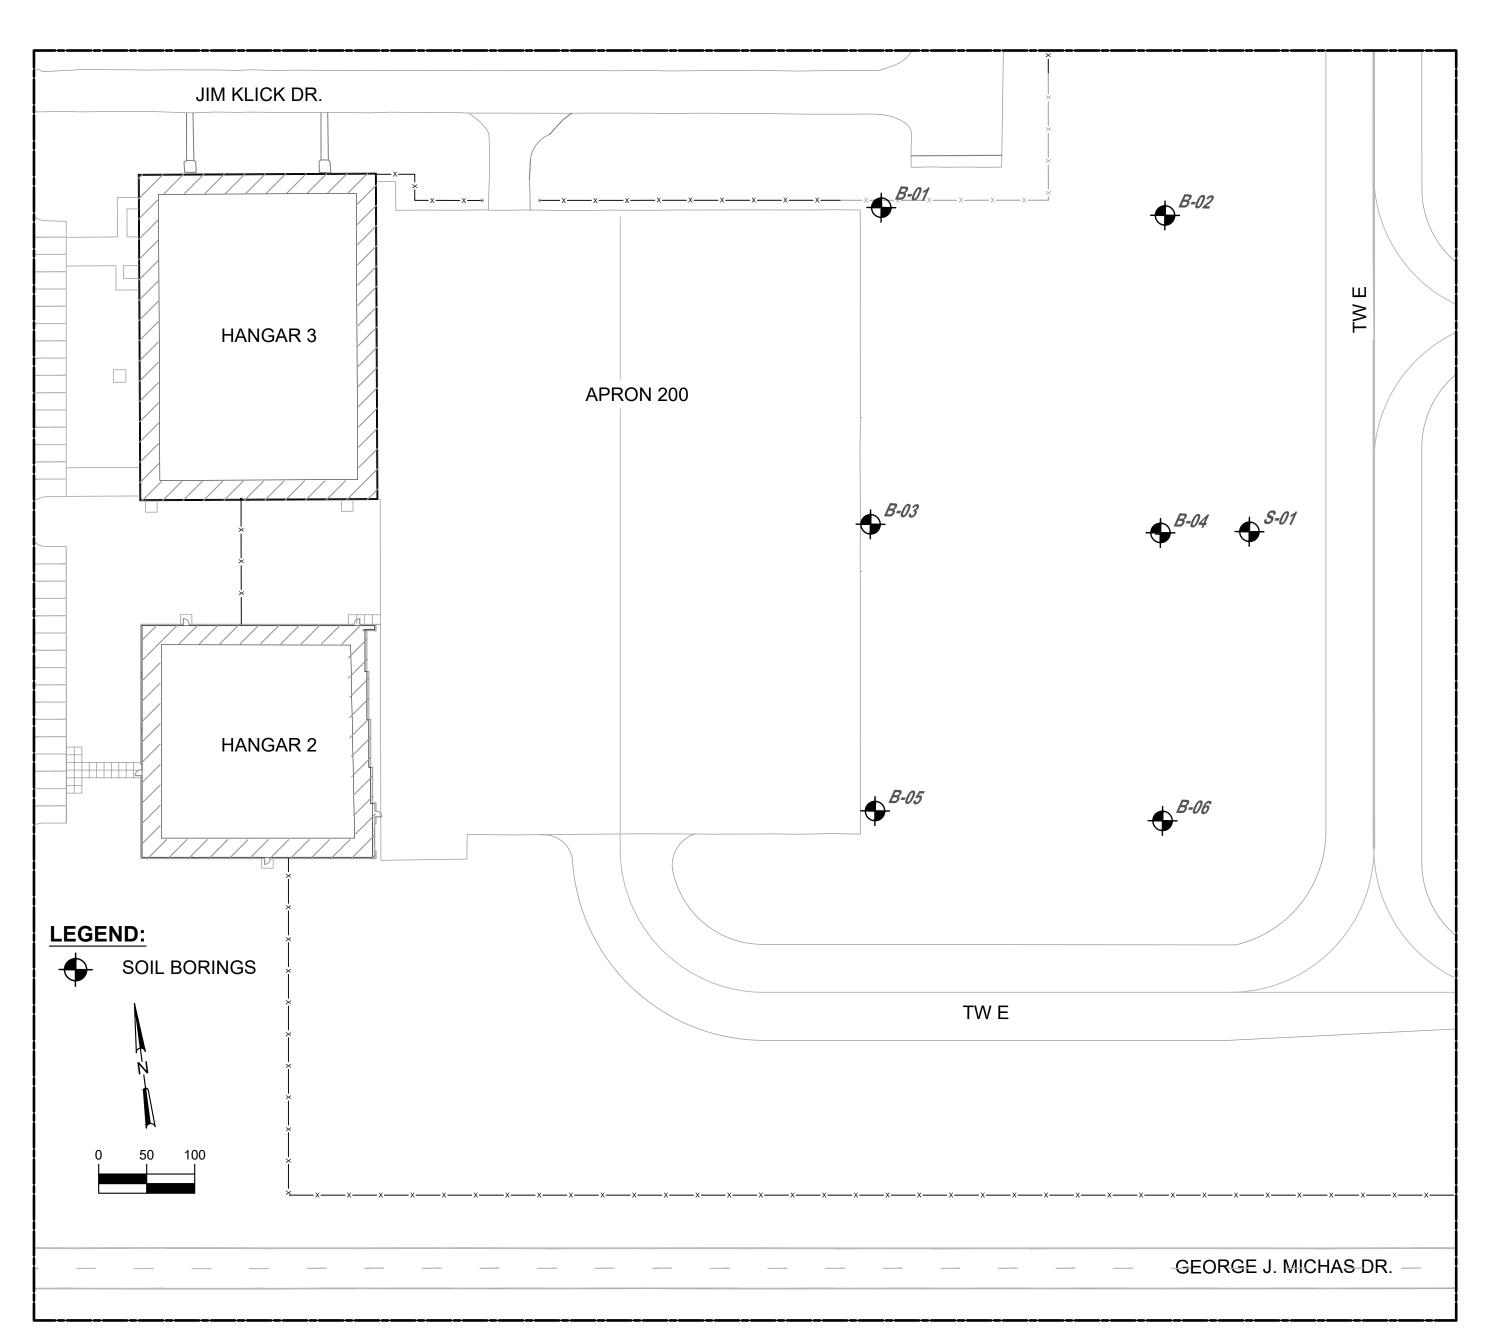

| | F [] N G [] | JT Neei | II) RIN | G II | NC. | Rubino Engineering 425 Shepard Drive Elgin, IL 60123 Telephone: 847-93 Fax: 847-931-1560 | 1-1555 | L | OG (| OF | BORI | NG B- | 01 Sheet 1 of |
|---|---------------------------|----------------|-------------------------------|---------------|---------------------------------|--|---|--------------------------------|-----------------------|-------------------|---|--|---|
| Rubino Project Locatio City, St Client: | : n: | No.: | LO ⁻ Lev Ror | vis U neov | sign A nivers rille, III | pron 200 Large Aircraft Hangar ity Airport inois neering, Ltd. | Drilling Method: Sampling Method: Hammer Type: Boring Location | od:Split S Auton : North | Spoon natic | er of H | | WATER ☑ While Drill ☑ Upon Com ☑ Delay | |
| (feet) | feet) | Log | Туре | No. | inches) | Station: N/A Offset: N/A | | | er 6-inch | %, % | TEST | PENETRATION DATA PENETRATION DATA PL | |
| Elevation (feet) | Depth, (feet) | Graphic Log | Sample Type | Sample No. | Recovery (inches) | MATERIAL DESC | CRIPTION | Classification | SPT Blows per 6-inch | Moisture, | o STREN | | Additional Remarks |
| | 0 | 13.15.1 | | | | Surface Elev.: 665.0 ft Approximately 6 inches of TO | DSOIL: dark | | | | | lac) | |
| | | | X | 1 | 14 | brown silty clay, with roots and Stiff, brown silty CLAY, trace | d organic matter / | CL | 10-5-3 N=8 | 20 | × | | Qp=2.0 tsf |
| 660- | - 5 - | | M | 2 | 18 | Soft, brown and gray sandy S Soft, brown and gray silty CLA | | ML | 2-1-2 N=3 | 23 | × | | Qp=0.5 tsf |
| | | | XI M | 3 | 18 18 | and gravel Color transitions to gray at app | | CL | 0-1-1 N=2 0-1-2 | 26 | | * | Qp=0.5 tsf 2% Organic Conter Qp=0.3 tsf |
| 655— | - 10 - | | X | 5 | 18 <u>\</u> | feet below existing grade Soft, gray SILT Loose to medium dense, gray | SAND and | ML | N=3 0-3-5 N=8 | 16 | \times | | Qp=0.3 tsf |
| 650— | - 15 - | | X | 6 | 18 | GRAVEL | SAND and | SP | 0-6-5 N=11 | 14 | | | |
| 645— | - 20 - | | X | 7 | 18 | Stiff, gray silty CLAY, trace sa | nd and gravel | _ | 5-3-6 N=9 | 16 | $\begin{array}{c c} & & \\ \hline & \times \\ \hline \end{array}$ | | Qp=3.5 tsf |
| 640— | - 25 - | | X | 8 | 14 | | | | 4-6-7 N=13 | 16 | × | | Qp=3.3 tsf |
| 635— | - 30 - | | X | 9 | 18 | | | CL | 3-5-7 N=12 | 17 | × | | Qp=3.3 tsf |
| 630— | - 35 - | | X | 10 | 18 | | | | 5-6-6 N=12 | 16 | × | | Qp=2.0 tsf |
| 625— | - 40 - | | X | 11 | 18 | End of boring at approximatel existing grade. | y 40 feet below | - | 5-7-8 N=15 | 16 | × | | Qp=3.0 tsf |
| Comple | etion E | L Depth: | | | 40.0 | ft Sample T | ypes: | Pressur | emeter | | e: 41.60520 | | |
| Date Book Date Book Drilling | oring (oring (By: | Starte Comp | | d: | 8/26/ 8/26/ J.K. Rubii | 24 Auger | Cutting poon | Shelby Grab Sa | Tube | Drill Ri Remar | ntry: H. Grego | 7822DT pse at 4 ft BE | G |

GENERAL NOTE

THE GEOTECHNICAL REPORT MAY BE REQUESTED FROM THE CONSTRUCTION MANAGER.









LEWIS UNIVERSITY AIRPORT

LARGE AIRCRAFT STORAGE HANGAR 405 JIM CLICK DRIVE ROMEOVILLE, ILLINOIS

| and the Control | l l | | CONTRACTOR OF THE PARTY. | The state of the s | Rubino Engineer 425 Shepard Dri Elgin, IL 60123 Telephone: 847 Fax: 847-931-15 | ve -931-1555 | L | OG | OF | BORI | NG B- | 02 Sheet 1 of 1 | | |
|---------------------|--|--|---|--|--|---|--|--|--|---|--|---|--|--|
| Job N n: ate: | | LO ⁻ Lev Ror | T De vis U neov | sign A nivers ville, Ill | ity Airport inois | gar Sampling Met | hod:Split e: Autor on: North | Spoon natic least corn | er of H | angar | ☑ While Drill ☑ Upon Con | WATER LEVELS*** While Drilling | | |
| | | Prir | nera | Engir | | | East | of existing | g apron | | | N/A | | |
| Depth, (feet) | Graphic Log | Sample Type | Sample No. | Recovery (inches) | Offset: N/A | SCRIPTION | Classification | SPT Blows per 6-inch | Moisture, % | X Moisture STREN Qu (Rin | F DATA | - Nemans | | |
| - - - | | XII | 1 | 10 | brown silty clay, with roots Black and dark brown HIGI SILTY CLAY, trace sand a | and organic matter H PLASTICITY | сн | 5-6-5 N=11 | 20 | | | Ωp=4.5 tsf LL = 52 PL = 22 | | |
| 5 - - | | XIII | 2 | 14 18 | Medium stiff, brown silty Cl and gravel Very soft, brown and gray s | | CL | N=6 | | | | 7% Organic Content Qp=2.0 tsf Qp=0.5 tsf | | |
| - | | A X | 4 | 16 - | , | ND and GRAVEL | CL | N=1 0-1-1 | 24 | | √ | 3% Organic Content Qp=0.3 tsf | | |
| 10 - - - | | | 5 | 8 | | | SM | 2-2-1 N=3 | 19 | × | | 7 | | |
| - 15 - | | X | 6 | 18 | Medium stiff, gray silty CLA gravel | AY, trace sand and | CL | 2-2-2 N=4 | 16 | × | | Qp=2.5 tsf | | |
| - - 20 - | | X | 7 | 18 | Stiff to very stiff, gray silty of and gravel | CLAY, trace sand | | 1-7-9 N=16 | 16 | * | | Qp=4.0 tsf | | |
| - - 25 - - | | X | 8 | 18 | | | | 2-6-7 N=13 | 26 | • | × | Qp=3.8 tsf | | |
| 30 - | | M | 9 | 18 | | | CL | 4-6-8 N=14 | 14 | | | Qp=3.0 tsf | | |
| - - 35 - - | | M | 10 | 18 | | | | 3-4-5 N=9 | 19 | × | | Qp=2.8 tsf | | |
| 40 - | | X | 11 | 18 | End of boring at approxima existing grade. | ately 40 feet below | | 3-6-6 N=12 | 17 | × | | Qp=2.5 tsf | | |
| ring S ring (| Started Compl | | d: | 8/26/ 8/26/ | 24 24 II Aug | ger Cutting | Shelby | Tube | Longitu Drill Ri Remar | ude: -88.088 g: Geoprobe ks: | 663° 7822DT | | | |


| Rubino Project Location | : on: | | LO ⁻ Lev Ror | vis U neov | sign A niversi rille, Illi | | angar S | Orilling Method: Sampling Method Hammer Type: Boring Location: | d:Split s Autor West | Spoon natic | of Hai | | Ī | Sheet 1 of 7 WATER LEVELS*** ▼ While Drilling 18 ½ ▼ Upon Completion 15 to 15 ▼ Delay N// | | | |
|-------------------------------|---|-------------|-------------------------------|---------------|----------------------------------|--|------------|---|--|------------------------|--|--------------------------|--|--|--------------------------------|--|--|
| Elevation (feet) | Depth, (feet) | Graphic Log | Sample Type | Sample No. | Recovery (inches) | eering, Ltd. Station: N/A Offset: N/A MATERIAL D | DESCR | RIPTION | Classification | SPT Blows per 6-inch | ure, % | × M | DARD PE TEST D o loisture 25 STRENGT | NETRATION ATA PL LL | | | |
| . <u> </u> | - 0 - | | X | 1 | 18 | Surface Elev.: 665.1 ft Approximately 6 inches of brown silty clay, with roof FILL: brown and gray sar | ts and o | rganic matter / | | 14-16-10 N=26 | | × | 2.0 | | 4.0 | | |
| 660- | - 5 - | | | 2 | 14 | FILL: black, brown, and g sand and gravel | gray silty | / clay, trace | | 7-5-7 N=12 2-1-3 | 22 | \(\frac{1}{\phi}\) | × | | Qp=4.3 tsf | | |
| | | | M M | 4 | 18 | Soft, brown and gray clay | yey SILT | Γ, trace | , KAI | N=4 0-1-2 | 35 | 0 | × | × | Qp=0.5 tsf | | |
| 655— | - 10 - | | M | 5 | 18 | Medium stiff to stiff, brow CLAY, trace sand and gr | | ray silty | ML | N=3 2-2-4 N=6 | 19 | | × | | 3% Organic Content Qp=2.5 tsf | | |
| 650— | - 15 - | | X | 6 | 18 | <u>.</u> | | | CL | 3-4-4 N=8 | 16 | | × | | Qp=2.5 tsf | | |
| 645— | - 20 - | | X | 7 | 10 | Dense, brown and gray p GRAVEL Elevated N-value due to p cobbles/boulders | | raded | GP | 49-28-12 N=40 | 15 | | × | | | | |
| 640— | - 25 - | | X | 8 | 18 | Medium stiff to stiff, gray sand and gravel | silty CL | AY, trace | | 2-3-4 N=7 | 19 | | × | | Qp=2.0 tsf | | |
| 635— | - 30 - | | X | 9 | 18 | | | | CL | 2-2-4 N=6 | 26 | 0 | × | | Qp=1.8 tsf | | |
| 630— | - 35 - | | X | 10 | 18 | | | | | 4-4-5 N=9 | 20 | | × | | Qp=2.5 tsf | | |
| | - 40 - | | X | 11 | 18 | Very stiff, gray silty CLA\ gravel End of boring at approxin existing grade. | | _ | CL | 5-7-9 N=16 | 20 | | × | | Qp=2.8 tsf | | |
| Date B Date B Logged | Completion Depth: 40.0 ft Sample Auguste Boring Started: 8/27/24 Spl. Auguste Boring Completed: 8/27/24 Spl. Auguste Boring Completed: J.K. Orilling Contractor: Rubino Engineering, Inc. | | | | | | | on 🖔 (| Pressur Shelby Grab Sa No Rec | Tube ample | Longitı Drill Ri Remar Log Er | ude: -8 g: Geo ks: | 604747° 8.08920 probe 7° Gregorio | 0° 322DT | | | |

| Rubino Job No.: G24.143 Project: LOT Design Apron 200 Large Location: Lewis University Airport City, State: Romeoville, Illinois Client: Primera Engineering, Ltd. | | | | | | linois neering, Ltd. | Drilling Method: Sampling Method: Sampling Method: Hammer Type: Boring Location: | | | | | Sheet 1 of 1 WATER LEVELS*** | | |
|--|--------------------|---------|-------------|------------|--------------------------------|---|--|------------------------------|------------------------|------------------------------|---|--|--------------------------|--|
| Elevation (feet) | Depth, (feet) | | Sample Type | Sample No. | Recovery (inches) | Station: N/A Offset: N/A MATERIAL DESC Surface Elev.: 663.3 ft | | Classification | SPT Blows per 6-inch | Moisture, % | X Moisture STREN Qu (Rim | PENETRATION DATA PL PL PENETRATION PANETRATION PANETRA | - Remarks | |
| 660- | | | X- | 1 | 10 | Approximately 10 inches of TC brown silty clay, with roots and Dark brown and black silty CL and gravel Possible Fill | d organic matter / | CL | 5-6-6 N=12 4-5-5 | 22 | » × | | Qp=3.8 tsf Qp=3.5 tsf | |
| | - 5 - | | | 3 | 14 | Medium stiff, gray clayey SILT | , trace gravel | ML | N=10 1-2-2 N=4 | 26 | | × | Qp=1.5 tsf | |
| 655— | - 10 - | | M | 4 | 18 | Medium stiff, gray silty CLAY, gravel | trace sand and | CL | 0-3-3 N=6 | 19 | × | | Qp=1.3 tsf | |
| 050 | | | X | 5 | 18 | Very stiff, brown and gray silty sand and gravel | CLAY, trace | | 4-7-8 N=15 | 16 | X | | Qp=4.5 tsf | |
| 650— | - 15 - | | X | 6 | 18 | | | CL | 4-7-9 N=16 | 15 | | | Qp=4.5 tsf | |
| 645— | - 20 - | | X | 7 | 18 | Medium stiff to stiff, gray silty sand and gravel | CLAY, trace | | 4-5-6 N=11 | 17 | × | | Qp=3.0 tsf | |
| 640— | - 25 - | | X | 8 | 14 | | | | 2-3-4 N=7 | 24 | > | < | Qp=1.3 tsf | |
| 635— | - 30 - | | X | 9 | 18 | | | CL | 4-5-6 N=11 | 15 | × | | Qp=3.0 tsf | |
| 630— | - 35 - | | X | 10 | 18 | | | | 3-6-7 N=13 | 19 | × | | Qp=2.8 tsf | |
| 625— | - 40 - | | X | 11 | 18 | End of boring at approximately existing grade. | y 40 feet below | | 3-4-5 N=9 | 16 | | | Qp=3.5 tsf | |
| Complete Book Book Book Book Book Book Book Boo | oring (| Started | | d: | 40.0 8/26/ 8/26/ J.K. | 24 Auger | Cutting | Pressur Shelby Grab Sa | Tube ample | Longitı Drill Ri Remaı | le: 41.60474 ude: -88.0886 g: Geoprobe ks: htry: H. Grego | 648° 7822DT | | |

3 PERMIT REVISIONS 06/06/25
2 PERMIT REVISIONS 05/02/25
1 BID ADDENDA 05/02/25
No. Description By Chk. App. Date Issues

GEOTECHNICAL
INVESTIGATION
INFORMATION - 1

APPROVED
RMH
CHECKED

SHEET NO.

GI002


DRAWN BY

JVJ


LE SAVED
(6/2025 10:06

| 333.00 | ************************************** | NEEF | - BSC-50-0961" | 12:0 00 05 | | Telephone: 847-93 Fax: 847-931-1560 |) | | | | | | Sheet 1 of 7 |
|--------------------|--|-------------------|----------------|-----------------------|-------------------|---|--|--------------------|----------------------|-----------|---|---------------------------|---------------------------------|
| Rubino | | No.: | | 4.143 | | 0001 | Drilling Method: | | | em Aug | er | | ER LEVELS*** |
| Project Locatio | | | | | - | opron 200 Large Aircraft Hangar Bity Airport | Sampling Methor Hammer Type: | a:Spiit : Autor | - | | | | _ |
| City, St | tate: | | Ro | meov | /ille, Ill | linois | Boring Location | | | | U | ▼ Upon 0 ▼ Delay | Completion N/A |
| Client: | | T | Prii | mera | Engir | neering, Ltd. Station: N/A | | East | of existing | g apron | 1 | | N/ <i>F</i> |
| | | | | | (Si | Offset: N/A | | | inch | | 1 | D PENETRATION ST DATA | ON |
| (feet | eet) | Log | ype | No. | nche | | | _ | er 6-i | % | \ \ \ \ \ \ \ \ \ \ \ \ \ \ \ \ \ \ \ | ⊚ ⊿ PL | |
| tion | Jepth, (feet) | Graphic Log | | Sample No. | iry (i | MATERIAL DES | CRIPTION | cation | d sw | Moisture, | X Moistu ₀ | re 🗕 🗀 | |
| Elevation (feet) | Dep | Grag | Sample Type | San | Recovery (inches) | | | Classification | SPT Blows per 6-inch | Moi | | | Remarks |
| ш | | | | | Re | • | | Ö | SP | | 1 | NGTH, tsf imac) ЖQp/C | Ωr |
| | 0 | 131 1× 11 | | | | Surface Elev.: 665.1 ft Approximately 6 inches of TC | PSOIL: dark | | | | 0 | 2.0 | 4.0 |
| | | \bowtie | | 1 | 10 | brown silty clay, with roots an | d organic matter / | | 6-3-3 | 21 | $\mid \stackrel{@}{ } \mid \; angle$ | < | Qp=4.5 tsf |
| | | \longrightarrow | | | | sand and gravel | | | N=6 | | | | |
| 660 | - 5 - | ₩ | | 2 | 18 | FILL: brown silty clay with sar | nd, trace gravel | | 3-4-4 N=8 | 17 | <u> </u> × | | Qp=3.5 tsf |
| 660 | | | | 3 | 18 | | | | 4-2-4 | 34 | | × | 2% Organic Conten |
| ŀ | | | M | 3 | Ιδ | FILL: black silty clay, trace sa | and gravel | - | 4-2-4 N=6 | | | | Qp=1.8 tsf |
| | | | | 4 | 18 | Medium stiff to stiff, brown an | nd aray silty | | 0-2-2 | 33 | 🔷 | × | 6% Organic Conter Qp=1.3 tsf |
| 655 | - 10 - | | | | | CLAY, trace sand and gravel | d gray silty | | N=4 | | | | φ-1.5 tsi |
| | | | | 5 | 18 | | | | 2-3-3 N=6 | 20 | $\left egin{array}{c c} & & & \end{array} ight \; 	imes$ | | Qp=2.0 tsf |
| - | | | | 6 | 18 | | | CL | 3-4-4 | 18 | | | Qp=3.0 tsf |
| 650 | - 15 - - | | | | | | | | N=8 | | | | |
| | _ : | | | | | | | | | | | | |
| ŀ | | | | - | 40 | Medium stiff to stiff, gray silty | CLAV trace | | 0.04 | | | | |
| 645 | - 20 - | | X | 7 | 18 | sand and gravel | CLAT, trace | | 2-3-4 N=7 | 20 | | | Qp=2.8 tsf |
| 0.0 | | | | | | | | | | | | | |
| | _ : | | | | | | | | | | | | |
| | | | M | 8 | 18 | | | | 2-4-6 | 21 | $ \hspace{.1cm} \H/\hspace{.1cm} \hspace{.1cm} >$ | < | Qp=2.3 tsf |
| 640 | - 25 - - - | | | | | | | | N=10 | | | | |
| | | | | | | | | | | | / | | |
| | | | | 9 | 18 | | | | 4-2-2 | 1 | | | 0,-0,8,45 |
| 635 | - 30 - | | | J | | | | CL | N=4 | 15 | $ \cdot \times$ | | Qp=0.8 tsf |
| | | | | | | | | | | | | | |
| | | <i>\\\\\</i> | | | | | | | | | | | |
| | - 35 - | | M | 10 | 18 | | | | 5-6-7 N=13 | 17 | | | Qp=3.8 tsf |
| 630 | | <i>\\\\\</i> | | | | | | | | | | | |
| | | | | | | | | | | | | | |
| | | | | 11 | 18 | | | | 4-6-7 | 19 | × | | Qp=3.8 tsf |
| | - 40 - | <i>\////</i> | | | | End of boring at approximate | ly 40 feet below | - | N=13 | | | | |
| | | | | | | existing grade. | | | | | | | |
| | | <u></u> | | | | | | | | 1 = 474 | 10. 44.0013 | 20% | |
| Comple Date Bo | | - | | | 40.0 8/27/ | 24 | <u>. </u> | Pressui | | Longit | le: 41.6043 ude: -88.08 | 9170° | |
| Date Bo | oring | | | d: | 8/27/ | I∎I Aliger | | Shelby Grab Sa | | | ig: Geoprob rks: hole co | e 7822DT llapse at 11 | ft BEG |
| Logged Drilling | - | ractor | | | J.K. Rubii | no Engineering, Inc. | · — | No Rec | | Log E | ntry: H. Greg ed By: | | |

| dii2 | NGI | | - BUEUGE | exercis e la | | | ne: 847-93° 7-931-1560 | 1-1333 | | | | | | Sheet 1 of | |
|--------------------|---------------|---------------|--------------|--------------|-------------------|--|---------------------------|---|----------------|---------------------------|-----------|-------------------------------------|-----------------------|-------------------|--|
| Rubino | Job | No.: | G2 | 4.143 | 3 | | | Drilling Method: | 2 ¼ F | Hollow Ste | m Aug | er | WATER | R LEVELS*** | |
| Project | :: | | | | - | pron 200 Large Airc | raft Hangar | Sampling Metho | - | - | | | ☑ While Dri | lling 18 ½ 1 | |
| Locatio | | | | | | ity Airport | | Hammer Type: | Autor | | | | ▼ Upon Completion N/A | | |
| City, St | tate: | | | | ille, III | | | Boring Location: | | neast corr of existing | | • | | | |
| Client: | | | | nera | Engin | eering, Ltd. Station: N/A | | | Last | OI GNISHIIQ | | | | 1 1 | |
| | | | | | <u>(6</u> | Offset: N/A | | | | 뒬 | | | PENETRATION DATA | | |
| et) |) (j | <u>p</u> | <u>e</u> | o. | hes | | | | | 6-ir | % | | © | | |
| n (fe | (fee | J | | Ž | (inc | MATER | IAI DESC | RIPTION | L C | ber | | × Moisture | ☑ PL | Additional | |
| atio | Depth, (feet) | Graphic Log | Sample Type | Sample No. | ery | IVIATEIN | AL DESC | ANII HON | licati | swo | Moisture, | 0 | ♣ LL | Remarks | |
| Elevation (feet) | Det | <u>ភ</u> ្ជ | San | Sal | Recovery (inches) | | | | Classification | SPT Blows per 6-inch | M | OTDEN. | DTIL 4 6 | + | |
| ш | | | | | Re | | | | Ö | SP | | STRENGTH, tsf ▲ Qu (Rimac) 米Qp/Qr | | | |
| | 0 | | Ш | | | Surface Elev.: 662 | | | | | | 1. | 2.0 4. | 0 | |
| | | | | | | Approximately 6 in brown silty clay, w | | | 1 | | | • | | | |
| 660- | | \bowtie | 103 | 1 | 0 | FILL: dark brown s | | | | 7-7-5 N=12 | 17 | | | | |
| | | \bowtie | | | | sand and gravel | | | | '' '- | | | | | |
| | - - | \bowtie | | 2 | 3 | FILL: black and brand gravel | own silty cla | y, trace sand | | 2-2-3 | 18 | Ĭ × | | Qp=2.0 tsf | |
| | - 5 - | \bowtie | | | | ū | | | | N=5 | | | | † | |
| 655— | | [<u> </u> | M | 3 | 18 | Soft to medium sti | ff, brown and | d gray clayey | 1 | 0-1-2 | 28 | | × | Qp=0.8 tsf | |
| 000- | L | | | | | SILT, trace gravel | | | ML | N=3 | | | | 3% Organic Conter | |
| | Ļ - | 1111 | M | 4 | 18 | Medium stiff, brow | n and arous | sandy silty | - | 0-1-3 | 20 | $ $ $ $ $ $ \times | | Qp=3.0 tsf | |
| | - 10 - | | | | | CLAY, trace grave | | oanuy Siity | CL | N=4 | 20 | + | | + | |
| 050 | | | M | 5 | 18 | Stiff, gray silty CLA | AY, trace sa | nd and gravel | | 3-3-5 | 17 | | | Qp=2.5 tsf | |
| 650- | | | | | | | | | | N=8 | '' | | | ' | |
| | | | M | 6 | 18 | | | | | 5-6-7 | 15 | | | Qp=4.5 tsf | |
| | - 15 - | | | | | | | | | N=13 | 13 | | | - | |
| | | | 1 | | | | | | | | | | | | |
| 645— | | | | | | | | | CL | | | | | | |
| | | | | 7 | 18 | | | | | 4-4-5 | . | | | 020 4-6 | |
| | - 20 - | | Ш | ′ | 10 | | | | | N=9 | 14 | \perp | | Qp=3.0 tsf | |
| | | | 1 | | | | | | | | | | | | |
| 640- | | \ //// | 1 | | | | | | | | | | | | |
| | - | | | | | Madium atiff and | ailth CLAY | troop pand and | - | | | | | | |
| | | | | 8 | 18 | Medium stiff, gray gravel | SIITY CLAY, | trace sand and | | 2-2-4 N=6 | 23 | $ \ \ \ \ \ \ $ | | Qp=2.3 tsf | |
| | - 25 - - | | | | | 3 | | | CL | '\-0 | | | | 7 | |
| 635— | | | 1 | | | | | | | | | \ | | | |
| | | | | | | | | | | | | | | | |
| | | | M | 9 | 18 | Stiff to very stiff, g | ray silty CLA | Y, trace sand | 1 | 9-8-7 | 24 | | ∤ | Qp=2.0 tsf | |
| | - 30 - | | | | | and gravel | | | | N=15 | | | | + | |
| 620 | | | 1 | | | | | | | | | | | | |
| 630- | | | | | | | | | | | | \ | | | |
| | | | M | 10 | 18 | | | | CL | 6-8-11 | 21 | 🖔 | | Qp=4.0 tsf | |
| | - 35 - | | | | , - | | | | CL | N=19 | 2 | \vdash \vdash \vdash \vdash | | | |
| | | | 1 | | | | | | | | | | | | |
| 625— | - | \/// | | | | | | | | | | / | | | |
| | | \ //// | | 44 | 40 | | | | | E 0 0 | | | | | |
| | - 40 - | | \mathbb{M} | 11 | 18 | | | 40.6 | | 5-6-8 N=14 | 21 | × | | Qp=4.0 tsf | |
| | -0 | | | | | End of boring at ap existing grade. | oproximately | 40 feet below | | | | | | | |
| | | | | | | oracaning grade. | | | | | | | | | |
| | | | | | | | | | | | | | | | |
| Comple | | | | | 40.0 | | Sample T | ypes: | Pressu | remeter | | de: 41.60434 | | | |
| Date B | _ | | | .d. | 8/27/ | | Auger | <u></u> | Shelby | | | ude: -88.0886 ig: Geoprobe | | | |
| Date B Logged | _ | Comp | ete | d : | 8/27/: J.K. | 24 | Split-S _l | | Grab S | | Rema | rks: hole colla | ipse at 6 ft BE | EG . | |
| .ogged Drilling | - | | | | | no Engineering, Inc. | | Rock Core O No Recovery Log Entry: H. Gregorich Checked By: | | | | | | | |

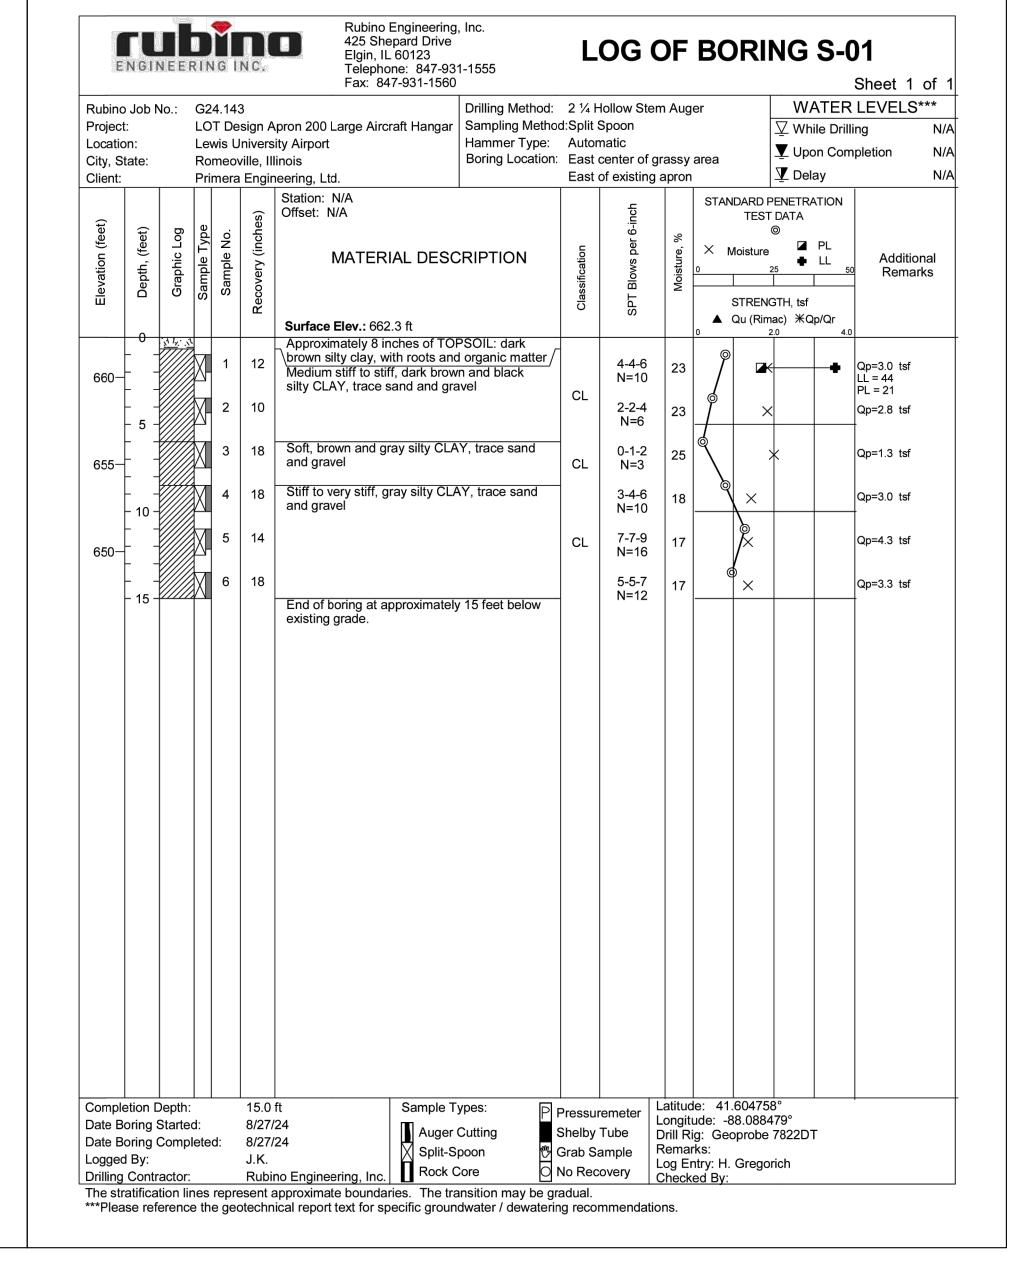



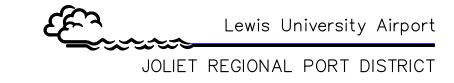





LARGE AIRCRAFT STORAGE HANGAR 405 JIM CLICK DRIVE ROMEOVILLE, ILLINOIS

| | | | | - |
|------|------------------|----|----------|----------|
| | | | | |
| | | | | |
| | DEDMIT DEVICIONS | | | 00/00/05 |
| _3_ | PERMIT REVISIONS | | | 06/06/25 |
| _2_ | PERMIT REVISIONS | | | 05/02/25 |
| _1_ | BID ADDENDA | | | 05/02/25 |
| No. | Description | Ву | Chk. App | . Date |
| Issu | es | | | |

GEOTECHNICAL
INVESTIGATION
INFORMATION - 2

APPROVED RMH
CHECKED


SHEET NO.

GI003

DRAWN BY


JVJ

FILE SAVED DATE PRINTED PRINTED BY

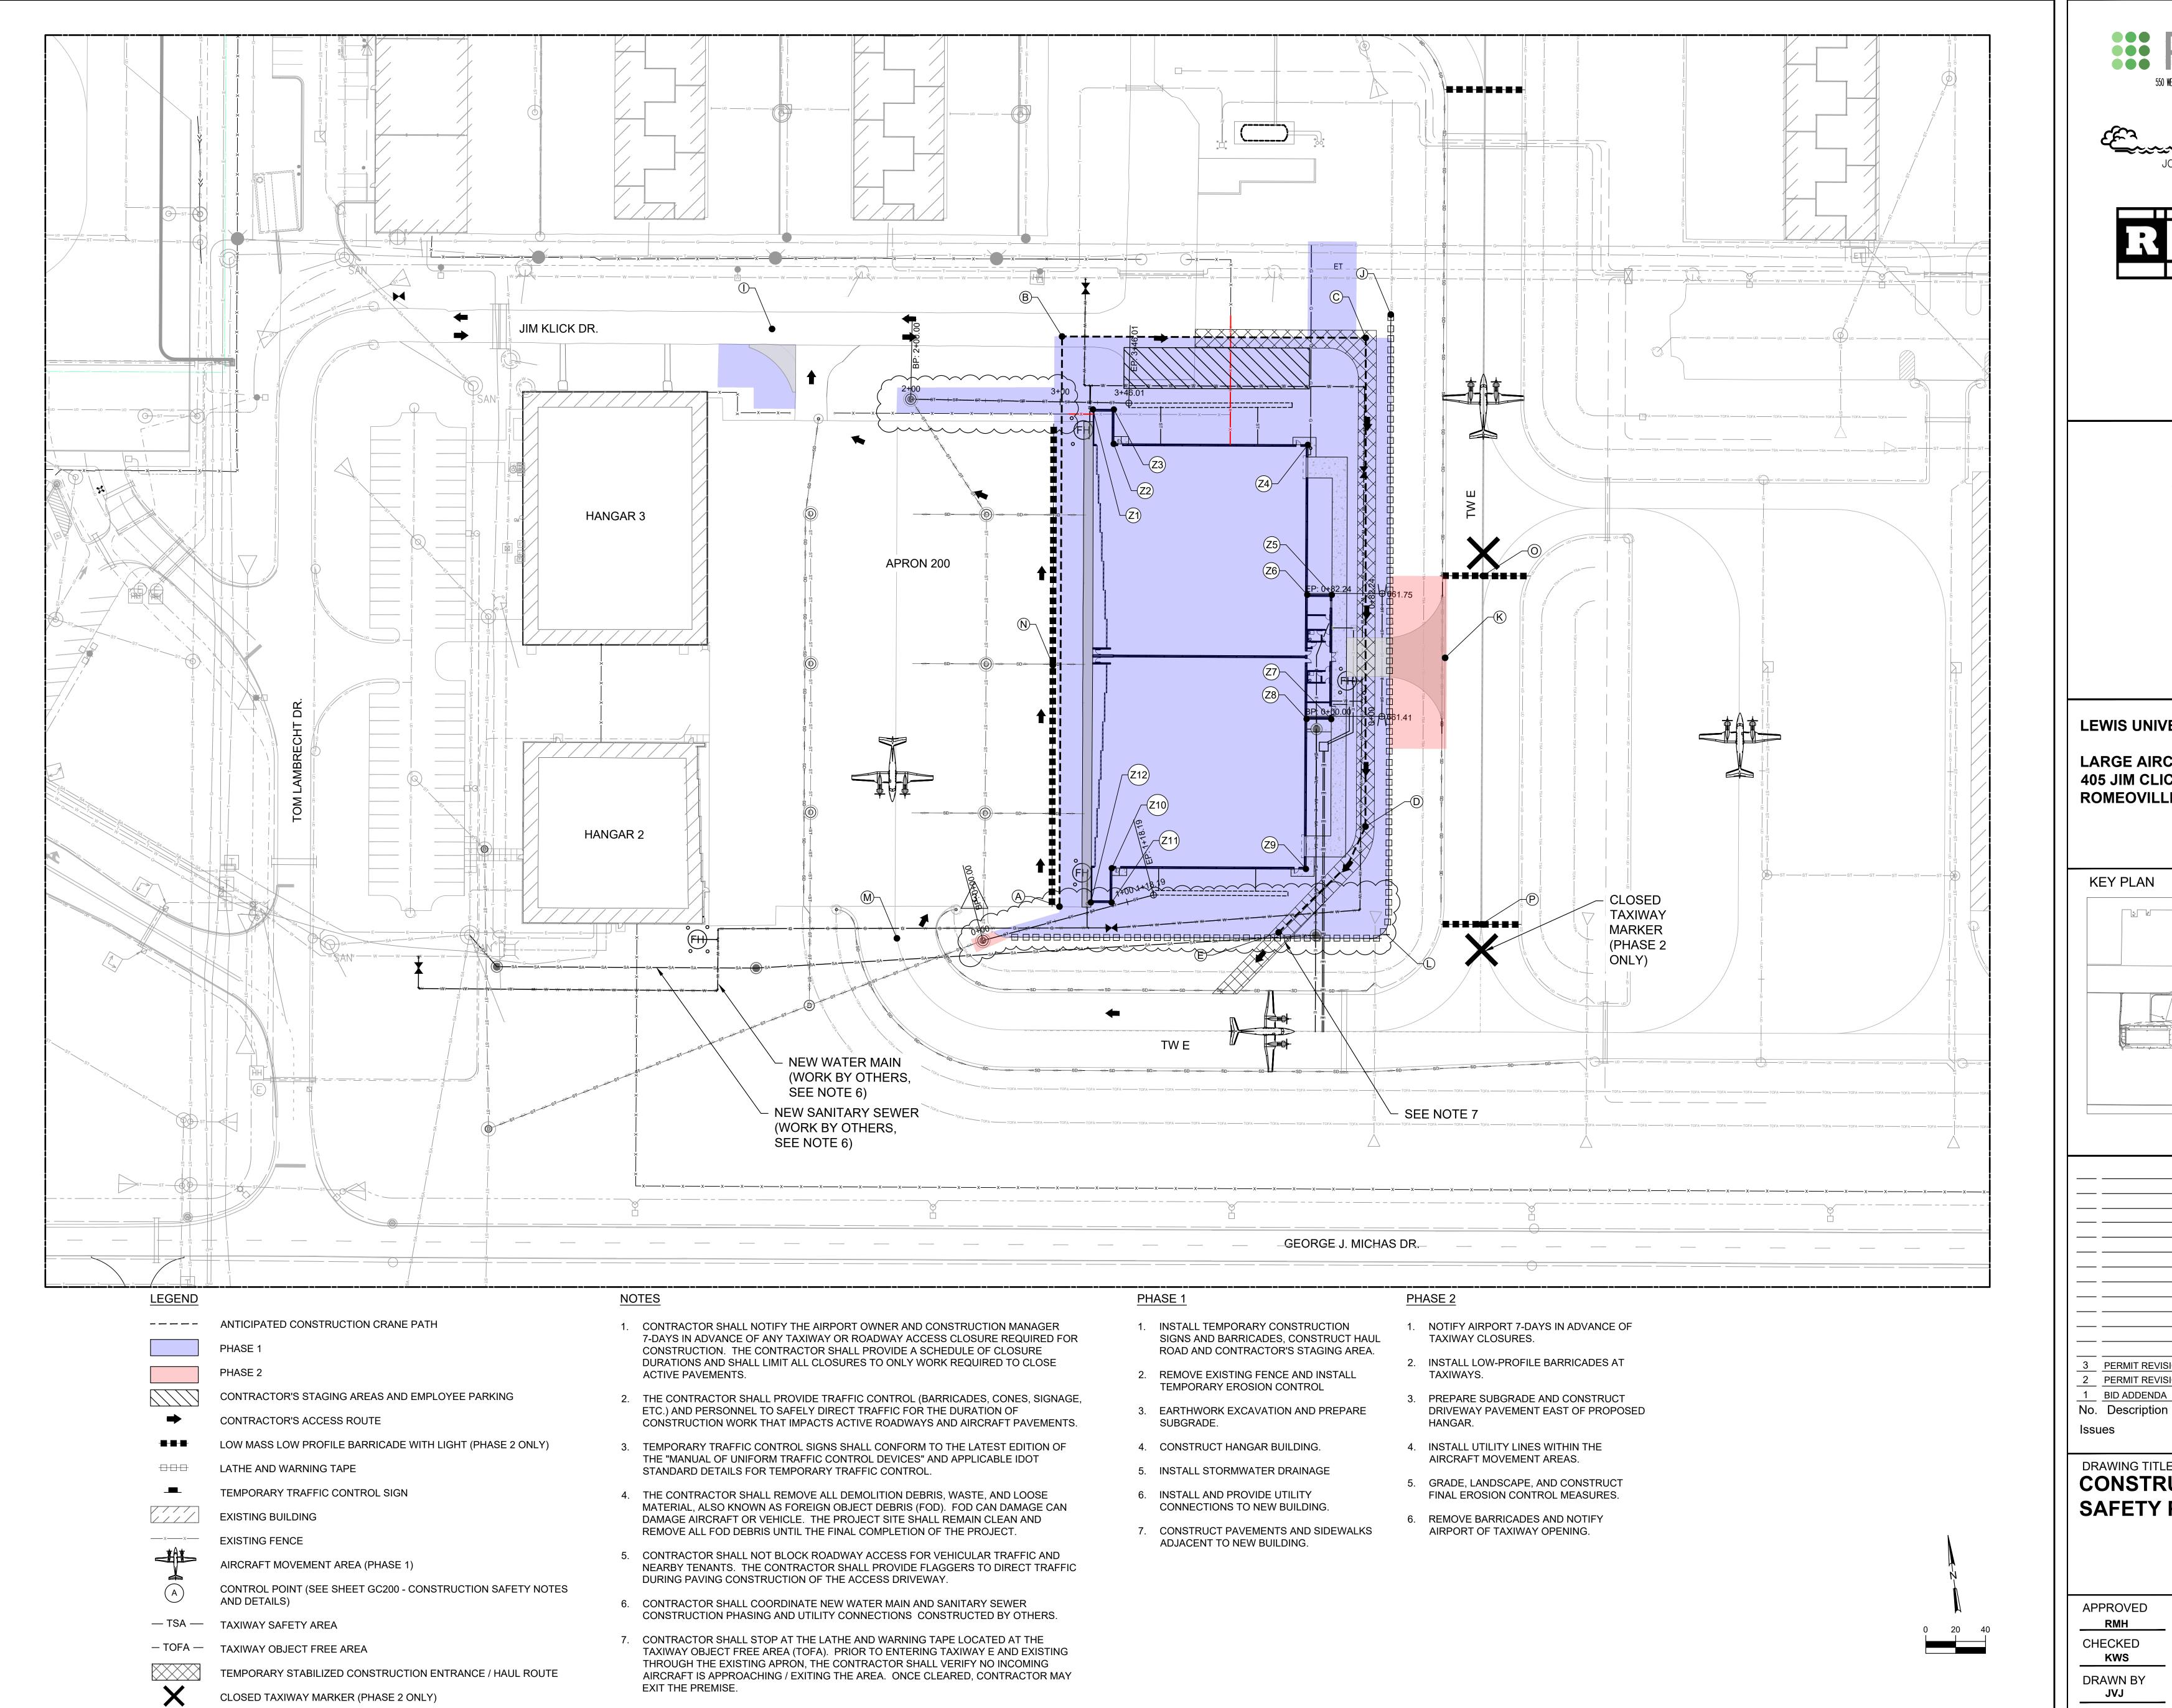


© 2007 Primera



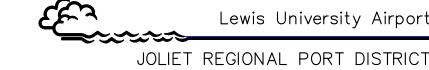




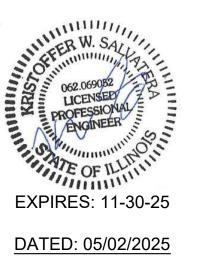

LEWIS UNIVERSITY AIRPORT

LARGE AIRCRAFT STORAGE HANGAR 405 JIM CLICK DRIVE ROMEOVILLE, ILLINOIS

KEY PLAN

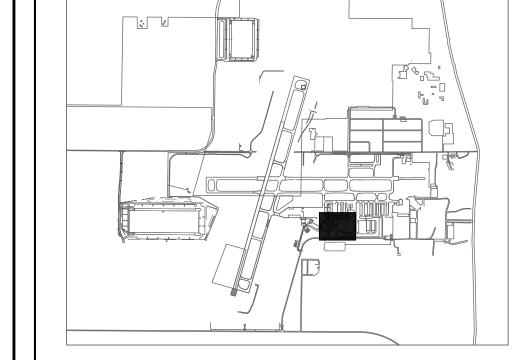

| · | |
|------------------|-------------------|
| | |
| | |
| | |
| | |
| | |
| | |
| | |
| | |
| PERMIT REVISIONS | 06/06/25 |
| PERMIT REVISIONS | 05/02/25 |
| BID ADDENDA | 05/02/25 |
| Description | By Chk. App. Date |

DRAWING TITLE CONSTRUCTION **SAFETY PLAN**

APPROVED CHECKED

KWS

JVJ

GC100

SHEET NO.

TO MINIMIZE DISRUPTIONS OF AIRPORT OPERATIONS, CONSTRUCTION OPERATIONS MUST BE CONTROLLED THROUGHOUT THE PROJECT'S DURATION, AND WORK MUST BE CONTROLLED THROUGHOUT THE PROJECT IS INCLUDED IN THE PLANS. THE CONTRACTOR SHALL PROVIDE HIS WRITTEN ACCEPTANCE OF THE PROJECT CONSTRUCTION PHASING PLAN AT THE PRE-CONSTRUCTION PHASING PLAN THE CONTRACTOR'S RESPONSIBILITY TO PROVIDE SUFFICIENT ADVANCE NOTICE OF ANY PROPOSED PHASING CHANGE TO PERMIT CONSIDERATION, NOR EXTENSION TO THE CONTRACT TIME, BECAUSE OF A PHASING CHANGE REQUEST NOR FOR

ANY TIME NECESSARY IN RECEIVING THE REQUIRED APPROVALS. THE CONTRACTOR SHALL EXPEDITE WORK AT THOSE STAGES WHERE ACTIVE RUNWAYS. HANGAR ACCESS. APRONS. ROADWAYS OR PARKING LOTS MUST BE CLOSED. TO MINIMIZE THE LENGTH OF TIME THAT AIRPORT OPERATIONS ARE RESTRICTED.

AT THE PRE-CONSTRUCTION CONFERENCE. THE CONTRACTOR SHALL PROVIDE A CONTRACTOR COORDINATION PLAN THAT COORDINATES HIS WORK WITH THE WORK OF HIS SUBCONTRACTORS AND THE WORK OF OTHER CONTRACTORS OF OTHER ON-GOING AIRPORT PROJECTS.

RUNWAY CLOSURE

NO RUNWAY CLOSURES ARE ANTICIPATED FOR THIS PROJECT

TEMPORARY BARRICADES

THE CONTRACTOR SHALL FURNISH BARRICADES FOR ANY AIRFIELD OR ROADWAY PAVEMENT TO BE CLOSED BY HIS WORK. IT WILL BE THE CONTRACTOR'S RESPONSIBILITY TO FURNISH, PLACE AND MAINTAIN BARRICADES AS SHOWN IN THE PLANS AND AS DIRECTED BY THE CONSTRUCTION MANAGER AND AIRPORT DIRECTOR. THE COST OF THESE ITEMS, AND THEIR MAINTENANCE, IS TO BE PAID UNDER ITEM AR150530 TRAFFIC MAINTENANCE. ANY WORK THAT REQUIRES PORTIONS OF AN ACTIVE TAXIWAY OR APRON TO BE CLOSED MUST BE COMPLETED EXPEDITIOUSLY TO MINIMIZE DISRUPTION TO AIRCRAFT OPERATIONS.

VEHICULAR TRAFFIC CONTROL

THE CONTRACTOR SHALL ERECT AND MAINTAIN. AT NO COST TO THE CONTRACT, DIRECTIONAL AND INFORMATIONAL SIGNS FOR THE CONTRACTOR'S ROUTE WITHIN THE AIRPORT OPERATIONS AREA. AS NOTED ON THE PLANS OR AS DIRECTED BY THE CONSTRUCTION MANAGER. WHERE CONTRACTOR EQUIPMENT IS OPERATING WITHIN ACTIVE AIRCRAFT OPERATIONS AREAS. RADIO-EQUIPED FLAGGERS SHALL BE FURNISHED TO REMOVE DEBRIS FROM ACTIVE AIRCRAFT MOVEMENT PATHS. THE COST OF TRAFFIC CONTROL/FLAGGERS AND PAVEMENT SWEEPING. SHALL BE PAID UNDER ITEM AR150530 TRAFFIC MAINTENANCE.

AIRFIELD OPERATIONAL SAFETY DURING CONSTRUCTION

AREA WHEN OPERATING VEHICLES SHALL BE REVOKED.

THE CONTRACTOR SHALL NOT HAVE ACCESS TO ANY PART OF THE ACTIVE AIRFIELD (RUNWAYS, TAXIWAYS OR APRONS) FOR ANY EQUIPMENT OR PERSONNEL WITHOUT THE APPROVAL OF THE ACTIVE AIRFIELD (RUNWAYS, TAXIWAYS OR APRONS) FOR ANY EQUIPMENT OR PERSONNEL WITHOUT THE AIRFIELD (RUNWAYS, TAXIWAYS OR APRONS) FOR APRONS OR HIGH REQUIREMENTS FOR AIRPORT SECURITY AND SAFETY, THE FOLLOWING REQUIREMENTS MUST BE ADHERED TO:

- ALL EMPLOYEES OF THE CONTRACTOR SHALL PARK THEIR PERSONAL VEHICLES IN THE DESIGNATED EQUIPMENT PARKING AND STORAGE AREA. EACH PERSON OR VEHICLE ENTERING THE CONTRACTOR WILL TRANSPORT THE WORKERS FROM THE PARKING AREAS TO THE WORK AREA. ONLY CONTRACTOR VEHICLES WILL BE ALLOWED OUTSIDE OF THE PROPOSED EQUIPMENT STORAGE AND PARKING AREAS.
- SHOULD ANY CONTRACTOR PERSONNEL BE IDENTIFIED AS NONCOMPLIANT WITH ANY VEHICLE RIVING SAFETY REQUIREMENTS IN THIS PROJECT SAFETY PLAN OR IN THE AIRPORT VEHICLE OPERATIONS, SUCH DRIVERS SHALL BE PENALIZED BY RESCISSION OF THEIR ON-AIRPORT DRIVING PRIVILEGES, AND THEIR ACCESS TO THE CONSTRUCTION LIMIT
- THE CONTRACTOR WILL BE REQUIRED TO BE IN CONTACT WITH AIRPORT OPERATIONS. THIS WILL KEEP THE CONTRACTOR IN CASE OF AN AERONAUTICAL EMERGENCY THAT WOULD REQUIRE ACTION BY THE CONTRACTOR AND/OR HIS PERSONNEL.

THE CONTRACTOR SHALL REMAIN WITHIN THE CONSTRUCTION LIMITS LINE SHOWN IN THE END OF ACTIVE RUNWAY 9-27, AND 250 FEET FROM THE END OF ACTIVE RUNWAY 9-27, AND 250 FEET FROM THE CENTERLINE AND 1,000 FEET FROM THE END OF ACTIVE RUNWAY 2-20. FOR WORK NEAR TAXIWAYS AND APRONS, THE CONTRACTOR'S PERSONNEL AND EQUIPMENT MUST REMAIN AT LEAST 44.5 FEET FROM ACTIVE CATEGORY II TAXIWAYS, AND TEN (10) FEET FROM ACTIVE APRONS. WHEN CONSTRUCTION OPERATIONS MUST BE CONDUCTED WITHIN THESE SEPARATIONS, THE PAVEMENT MUST BE CLOSED TO AIRCRAFT ACTIVITY BY THE CONTRACTOR BY PROVIDING TEMPORARY BARRICADES AS SHOWN IN THE PLANS, AND IN THE CASE RUNWAY PAVEMENTS, CLOSED RUNWAY MARKERS.

NO CLOSURE OF ANY RUNWAY WILL BE PERMITTED FOR THIS PROJECT.

THE CONTRACTOR SHALL KEEP ALL OF HIS EQUIPMENT AND PERSONNEL AT LEAST 15 FEET FROM THE EDGE OF ANY ACTIVE ROAD/PAVEMENT EDGE, THE CONTRACTOR SHALL PROVIDE FOR TRAFFIC CONTROL IN ACCORDANCE WITH IDOT SPECIFICATIONS (HIGHWAY STANDARDS).

OPEN TRENCHES, EXCAVATIONS AND STOCKPILED MATERIAL AT THE CONSTRUCTION SITE SHALL BE DELINEATED WITHIN THE RUNWAY OR TAXIWAY IS OPEN TO AIR TRAFFIC (INCLUDING OVERNIGHT). THE RSA IS DEFINED AS 250 FEET FROM THE CENTERLINE AND 1,000 FEET FROM THE CENTERLI CENTERLINE, AND 59 FEET FROM THE CATEGORY III TAXIWAY CENTERLINE. 

WHEN NOT IN USE AND DURING NONWORKING HOURS, CONTRACTOR'S EQUIPMENT STORAGE AND PARKING AREAS. THE EQUIPMENT STORAGE AND PARKING AREAS.

AT NO TIME SHALL THE CONTRACTOR CONDUCT ANY ACTIVITIES OR OPERATE OR PARK EQUIPMENT SO AS TO OBSTRUCT ACTIVE PART 77 AIRPORT IMAGINARY SURFACES OR THE RUNWAY PROTECTION ZONES (RPZ) AS DELINEATED IN THE PLANS. CONTRACTOR'S EQUIPMENT SHALL EXTEND NO HIGHER THAN 20 FEET. CRANES SHALL NOT BE USED DURING INSTRUMENT WEATHER CONDITIONS OR AT NIGHT. CRANES SHALL BE LOWERED WHEN NOT IN USE.

BEFORE REOPENING TEMPORARILY CLOSED PAVEMENTS, THE CONTRACTOR SHALL INSPECT AND CLEAN, AS NECESSARY, THE PAVEMENT TO ASSURE THAT NO MATERIALS OR OBJECTS THAT MAY DAMAGE AIRCRAFT OR VEHICLES REMAIN. ANY REQUIRED CLEANING SHALL BE TO THE SATISFACTION OF THE CONSTRUCTION MANAGER AND AIRPORT OWNER AND IS INCIDENTAL TO THE CONTRACT.

ALL WORK SHALL BE COMPLETED IN ACCORDANCE WITH THE APPROVED PROJECT SAFETY PLAN, ISSUED BY THE ILLINOIS DIVISION OF AERONAUTICS.

FAILURE TO USE THESE PRESCRIBED PROCEDURES OR ADHERE TO THE SAFETY REQUIREMENTS WILL RESULT IN THE SUSPENSION OF WORK.

NOTIFICATIONS BY CONTRACTOR

THE CONTRACTOR MUST NOTIFY THE CONSTRUCTION MANAGER AND THE AIRPORT OWNER 3 DAYS IN ADVANCE OF ANY REQUIRED DURATION OF THE CLOSING MUST BE APPROVED BY THE CONSTRUCTION MANAGER AND THE AIRPORT OWNER. THE CONTRACTOR SHALL NOTIFY THE CONSTRUCTION MANAGER AND AIRPORT OWNER 3 DAYS IN ADVANCE OF THE CONTRACTOR'S CLOSING OF OTHER ACTIVE ROADWAYS. AIRFIELD OR ROADWAY LIGHTING CIRCUITS, OR OTHER AIRPORT FACILITIES.

CONTRACTOR'S USE OF SITE

CONTRACTOR'S ACCESS TO THE PROJECT WHEN ON AIRPORT PROPERTY IS SHOWN IN THE PLANS. CONTRACTOR IS TO SECURE ALL NECESSARY PERMITS FOR THE USE OF ANY PUBLIC RIGHTS-OF-WAY AND IS TO MAINTAIN TRAFFIC ON THESE PUBLIC ROADS AT ALL TIMES, WITH THE COSTS OF PERMITTING, CLEANING AND REPAIRING OF PAVEMENT DAMAGED BY CONTRACTOR'S ACTIVITIES INCIDENTAL TO THE CONTRACT. USE OF AND REPAIRS TO ANY PUBLIC FACILITIES ARE TO BE COMPLETED TO THE SATISFACTION OF THE FACILITY'S OWNER.

THE CONTRACTOR IS TO PROVIDE TEMPORARY CONSTRUCTION ROADS WITHIN THE CONSTRUCTION LIMIT LINES AS MAY BE REQUIRED BY THE AIRPORT OWNER AND THE CONSTRUCTION MANAGER. ANY DAMAGE TO PAVEMENTS THAT MAY OCCUR BY THE CONTRACTOR'S ACTIVITIES SHALL BE REPAIRED AT THE CONTRACTOR'S EXPENSE AND TO THE SATISFACTION OF THE AIRPORT OWNER AND THE CONTRACTOR SHALL GRADE, LEVEL, TOPSOIL, SEED AND MULCH AT THE END OF THE PROJECT, SEE DETAIL SHEET 5 PAID UNDER ITEM AR150540 HAUL ROUTE.

THE CONTRACTOR IS TO PROVIDE AN EQUIPMENT STORAGE AND PARKING AREA AT THE LOCATIONS SHOWN IN THE ACCESS ROADS AND THE AREAS AT PROJECT COMPLETION TO CONDITIONS SUITABLE TO THE AIRPORT OWNER AND THE CONSTRUCTION MANAGER. AT THE AIRPORT OWNER'S DISCRETION, THE TEMPORARY FACILITIES IS INCIDENTAL TO THE CONTRACT.

UTILITY OUTAGES AND SHUTDOWNS

THE CONTRACTOR SHALL PROVIDE 3 DAYS PRIOR NOTICE OF ANY OUTAGES OR SHUTDOWNS TO THE OWNER AND THE AGENCY OWNING THE AGENCY AT NO COST TO THE OWNER.

Z12

665.65

BUILDING

APPROX.


GROUND

EQUIPMENT OR | EQUIPMENT OR

711.7


1798499.6017'

CONSTRUCTION STUCTURE STRUCTURE

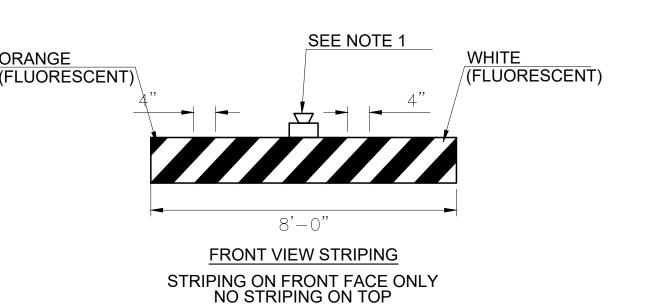

LOW MASS LOW PROFILE BARRICADE DETAILS

- CONTRACTORS TO PROVIDE CONSTRUCTION BARRICADES WITH A LIGHT (MODEL L-204, 360° RED LENS) ATTACHED TO EACH LOW MASS LOW PROFILE BARRICADE. LOW MASS LOW PROFILE BARRICADES ARE TO BE PLASTIC WATER FILLED ONLY. ALL COSTS ASSOCIATED WITH PICK-UP, DELIVERY, INSTALLATION, AND REMOVAL OF ALL LIGHTS. BARRICADES. BATTERIES. MOUNTING HARDWARE. MAINTENANCE. INCIDENTALS. AND ALL SIGNS REQUIRED TO CONTROL CONSTRUCTION TRAFFIC AS SHOWN ON THE PLANS ARE INCIDENTAL TO THE WORK.
- 2. BARRICADES MUST BE PLACED AT LOCATIONS INDICATED ACROSS THE ENTIRE WIDTH OF PAVEMENT TO PREVENT AIRCRAFT ACCESS AS REQUIRED FOR EACH WORK AREA. THE LOCATION, NUMBER OF BARRICADES TO BE PLACED, AND DURATION WILL BE AT THE DIRECTION OF THE CONSTRUCTION MANAGER AND AIRPORT

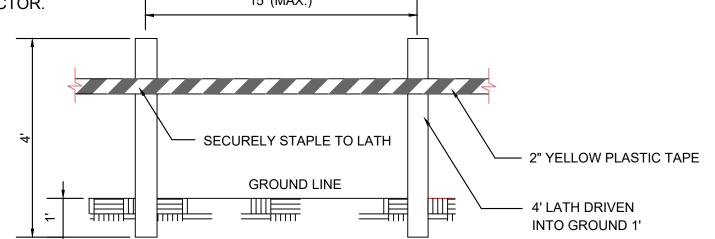

MATERIALS ARE TO BE APPROVED BY CONSTRUCTION MANAGER PRIOR TO INSTALLATION.

LATHE AND WARNING TAPE - DETAIL A

3.00' ──

COLOR

CONTRACTOR.

CONSTRUCTION EQUIPMENT AND TRUCK SIGNAL FLAG

CLOSED TAXIWAY MARKING DETAIL

1. TAXIWAY VINYL MARKERS TO BE FURNISHED BY THE

MARKERS TO BE SECURED BY CONTRACTOR AS

RECOMMENDED BY THE MANUFACTURER.

ALL VEHICLES OPERATING ON THE ACTIVE AIRFIELD SHALL BE EQUIPPED WITH A FLAG PLACED AT THE HIGHEST POINT OF THE VEHICLE AND A YELLOW ROTATING BEACON TO ENSURE MAXIMUM VISIBILITY.

| CRITICAL POINT | ELEVATION (FT) | EQUIPMENT OR STRUCTURE | HEIGHT (FT) (AGL) | ELEVATION (FT) (AMSL) | NORTHING | EASTING | LATITUDE | LONGITUDE | NOTICE | DURATION | COMPONENT TYPE | DEVELOPMENT TYPE |
|-------------------|----------------|------------------------|----------------------|--------------------------|---------------|---------------|------------------|------------------|--------------|----------|-------------------|------------------------------|
| А | 665.38 | CRANE | 175 | 840.4 | 1798495.8350' | 1051004.1620' | N041° 36' 15.49" | W088° 05' 21.30" | CONSTRUCTION | TEMP | PART 77 | CONTRUCTION/MOBILE EQUIPMENT |
| В | 665.29 | CRANE | 175 | 840.3 | 1798877.2446' | 1050988.0187' | N041° 36' 19.26" | W088° 05' 21.50" | CONSTRUCTION | TEMP | PART 77 | CONTRUCTION/MOBILE EQUIPMENT |
| С | 663.71 | CRANE | 175 | 838.7 | 1798885.8420' | 1051191.1442' | N041° 36' 19.34" | W088° 05' 18.83" | CONSTRUCTION | TEMP | PART 77 | CONTRUCTION/MOBILE EQUIPMENT |
| D | 661.66 | CRANE | 175 | 836.7 | 1798558.9302' | 1051206.2976' | N041° 36' 16.11" | W088° 05' 18.64" | CONSTRUCTION | TEMP | PART 77 | CONTRUCTION/MOBILE EQUIPMENT |
| Е | 662.82 | CRANE | 175 | 837.8 | 1798485.4128' | 1051151.5390' | N041° 36' 15.38" | W088° 05' 19.36" | CONSTRUCTION | TEMP | PART 77 | CONTRUCTION/MOBILE EQUIPMENT |
| I | 665.73 | SEMI/DUMP TRUCK | 25 | 690.7 | 1798873.1749' | 1050793.8370' | N041° 36' 19.22" | W088° 05' 24.06" | CONSTRUCTION | TEMP | PART 77 | CONTRUCTION/MOBILE EQUIPMENT |
| J | 663.76 | SEMI/DUMP TRUCK | 25 | 688.8 | 1798902.2005' | 1051207.1660' | N041° 36' 19.50" | W088° 05' 18.62" | CONSTRUCTION | TEMP | PART 77 | CONTRUCTION/MOBILE EQUIPMENT |
| К | 664.14 | SEMI/DUMP TRUCK | 25 | 689.1 | 1798674.3164' | 1051254.2594' | N041° 36' 17.25" | W088° 05' 18.00" | CONSTRUCTION | TEMP | PART 77 | CONTRUCTION/MOBILE EQUIPMEN |
| L | 662.20 | SEMI/DUMP TRUCK | 25 | 687.2 | 1798487.2536' | 1051223.6866' | N041° 36' 15.40" | W088° 05' 18.41" | CONSTRUCTION | TEMP | PART 77 | CONTRUCTION/MOBILE EQUIPMENT |
| M | 665.21 | SEMI/DUMP TRUCK | 25 | 690.2 | 1798469.4964' | 1050896.4305' | N041° 36' 15.23" | W088° 05' 22.72" | CONSTRUCTION | TEMP | PART 77 | CONTRUCTION/MOBILE EQUIPMENT |
| N | 665.28 | SEMI/DUMP TRUCK | 25 | 690.3 | 1798657.0616' | 1050992.1496' | N041° 36' 17.08" | W088° 05' 21.46" | CONSTRUCTION | TEMP | PART 77 | CONTRUCTION/MOBILE EQUIPMEN |
| 0 | 664.34 | SEMI/DUMP TRUCK | 25 | 689.3 | 1798730.2980' | 1051276.9118' | N041° 36' 17.80" | W088° 05' 17.70" | CONSTRUCTION | TEMP | PART 77 | CONTRUCTION/MOBILE EQUIPMEN |
| Р | 664.22 | SEMI/DUMP TRUCK | 25 | 689.2 | 1798497.1856' | 1051286.7809' | N041° 36' 15.50" | W088° 05' 17.58" | CONSTRUCTION | TEMP | PART 77 | CONTRUCTION/MOBILE EQUIPMENT |
| Z1 | 665.65 | BUILDING | 46 | 711.7 | 1798829.4115' | 1051010.9663' | N041° 36' 18.79" | W088° 05' 21.20" | CONSTRUCTION | PERM | HANGAR | HANGAR CONSTRUCTION |
| Z2 | 665.65 | BUILDING | 46 | 711.7 | 1798807.0537' | 1051025.9254' | N041° 36' 18.56" | W088° 05' 21.01" | CONSTRUCTION | PERM | HANGAR | HANGAR CONSTRUCTION |
| Z3 | 665.65 | BUILDING | 46 | 711.7 | 1798830.0037' | 1051024.9538' | N041° 36' 18.79" | W088° 05' 21.02" | CONSTRUCTION | PERM | HANGAR | HANGAR CONSTRUCTION |
| Z4 | 665.65 | BUILDING | 46 | 711.7 | 1798812.4684' | 1051155.7918' | N041° 36' 18.61" | W088° 05' 19.30" | CONSTRUCTION | PERM | HANGAR | HANGAR CONSTRUCTION |
| Z5 | 665.65 | BUILDING | 17.5 | 683.2 | 1798712.8400' | 1051176.5349' | N041° 36' 17.63" | W088° 05' 19.03" | CONSTRUCTION | PERM | HANGAR | HANGAR CONSTRUCTION |
| Z6 | 665.65 | BUILDING | 46 | 711.7 | 1798712.1451' | 1051160.1225' | N041° 36' 17.62" | W088° 05' 19.24" | CONSTRUCTION | PERM | HANGAR | HANGAR CONSTRUCTION |
| Z 7 | 665.65 | BUILDING | 17.5 | 683.2 | 1798629.7326' | 1051180.0534' | N041° 36' 16.81" | W088° 05' 18.98" | CONSTRUCTION | PERM | HANGAR | HANGAR CONSTRUCTION |
| Z8 | 665.65 | BUILDING | 46 | 711.7 | 1798629.0342' | 1051163.5577' | N041° 36' 16.80" | W088° 05' 19.20" | CONSTRUCTION | PERM | HANGAR | HANGAR CONSTRUCTION |
| Z 9 | 665.65 | BUILDING | 46 | 711.7 | 1798528.7226' | 1051167.8046' | N041° 36' 15.81" | W088° 05' 19.15" | CONSTRUCTION | PERM | HANGAR | HANGAR CONSTRUCTION |
| Z10 | 665.65 | BUILDING | 46 | 711.7 | 1798523.1414' | 1051037.9453' | N041° 36' 15.76" | W088° 05' 20.86" | CONSTRUCTION | PERM | HANGAR | HANGAR CONSTRUCTION |
| Z11 | 665.65 | BUILDING | 46 | 711.7 | 1798500.1915' | 1051038.9169' | N041° 36' 15.53" | W088° 05' 20.85" | CONSTRUCTION | PERM | HANGAR | HANGAR CONSTRUCTION |


CRITICAL POINTS TABLE

FAA OE-AAA AIRSPACE CASE NUMBERS 2025-AGL-5328 THROUGH 2025-AGL-5340 AND 2025-AGL-5343 THROUGH 2025-AGL-5355


1051024.9868' | N041° 36' 15.53" | W088° 05' 21.03" |

CONSTRUCTION



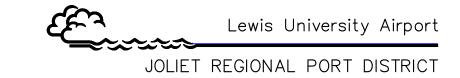




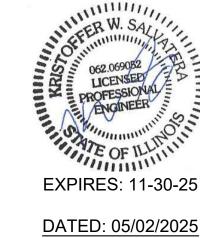

LEWIS UNIVERSITY AIRPORT

LARGE AIRCRAFT STORAGE HANGAR **405 JIM CLICK DRIVE** ROMEOVILLE, ILLINOIS

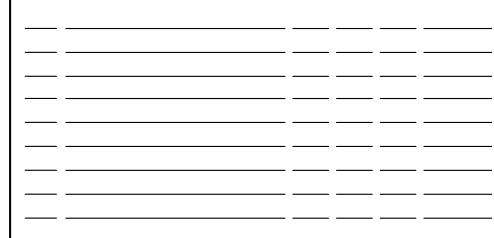

| 3 | PERMIT REVISIONS | | 06/06/25 |
|-----|------------------|-----------|----------|
| 2 | PERMIT REVISIONS | | 05/02/25 |
| 1_ | BID ADDENDA | | 05/02/25 |
| No. | Description | By Chk. A | pp. Date |

DRAWING TITLE

Issues

HANGAR CONSTRUCTION

HANGAR

CONSTRUCTION SAFETY NOTES AND **DETAILS**


APPROVED CHECKED

SHEET NO.

GC200

KWS

DRAWN BY

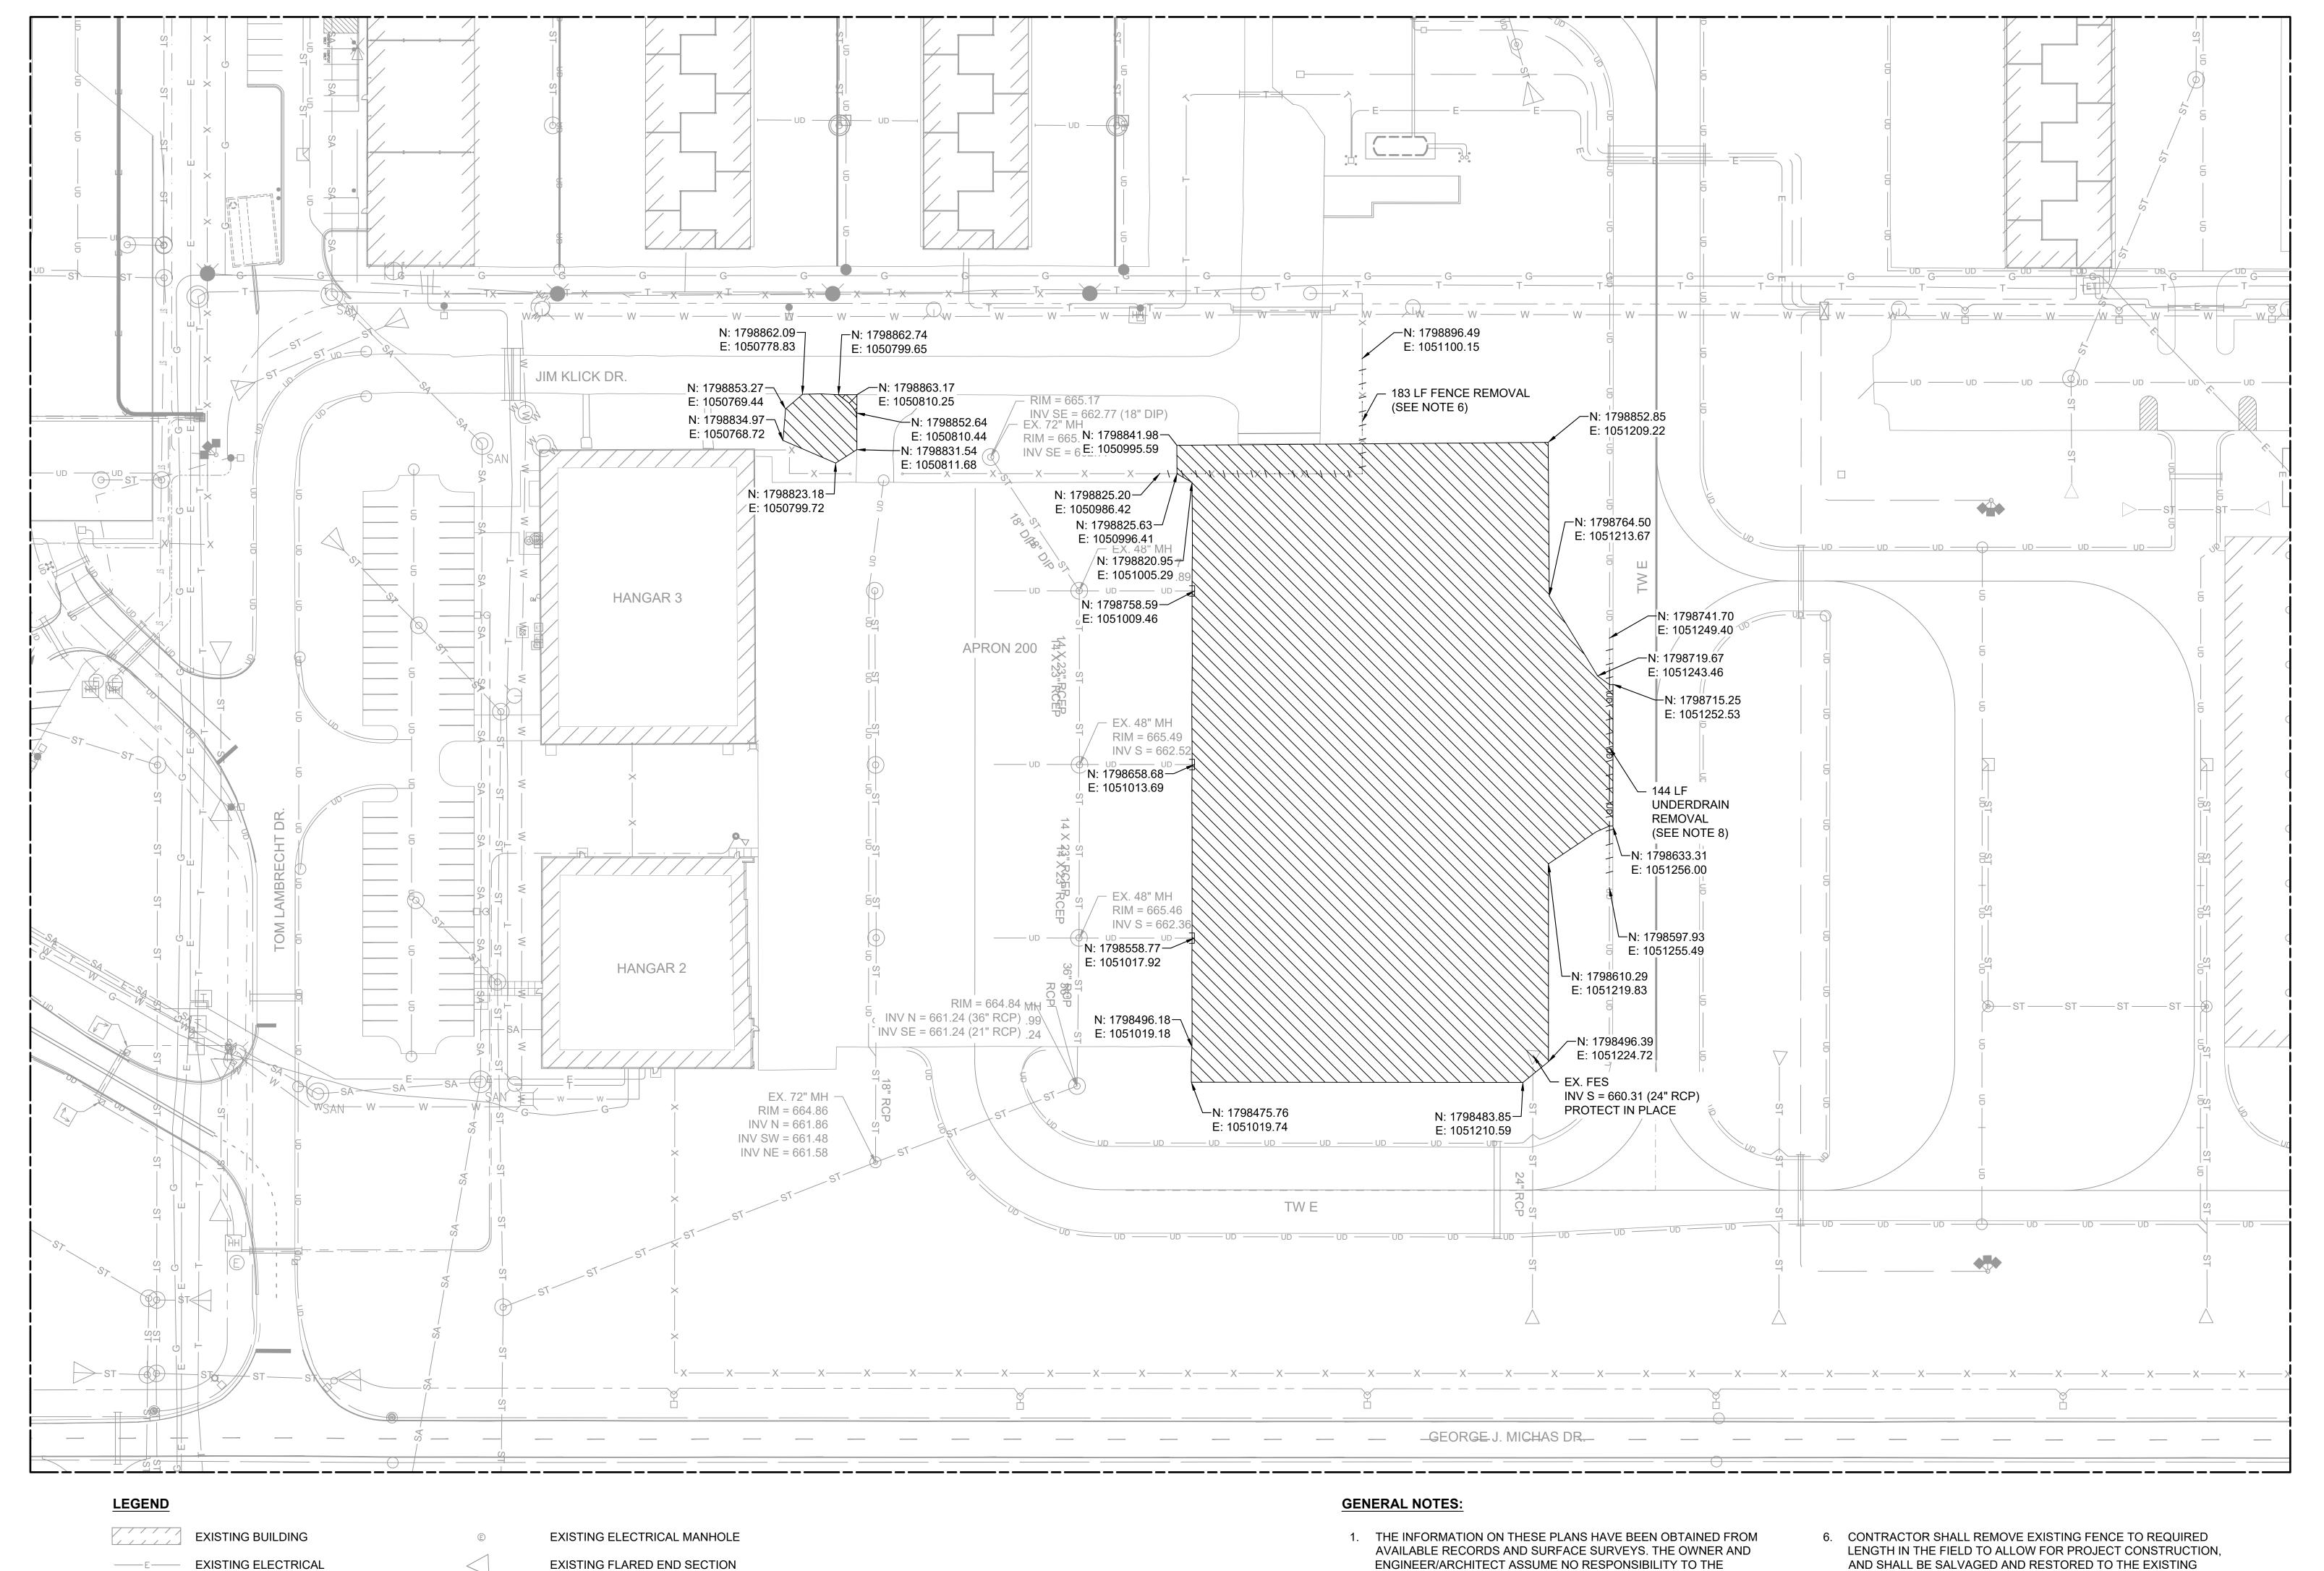

——E—— EXISTING ELECTRICAL ———G—— EXISTING NATURAL GAS ——SA—— EXISTING SANITARY SEWER

——ST — EXISTING STORM SEWER ———— EXISTING TELECOMMUNICATIONS —— UD —— EXISTING UNDERDRAIN

---- W ---- EXISTING WATER

——X—— EXISTING FENCE . | . | . | . | .

EXISTING HANDHOLE EXISTING HYDRANT

EXISTING LIGHT POLE EXISTING SEWER MANHOLE

> EXISTING TELECOMMUNICATIONS MANHOLE PROPOSED TOPSOIL/EARTHWORK STRIPPING

PROPOSED PAVEMENT DEMOLITION PROPOSED REMOVAL

PROPOSED UNDERDRAIN CAP/PLUG


- ENGINEER/ARCHITECT ASSUME NO RESPONSIBILITY TO THE ACCURACY OF THE INFORMATION PROVIDED AND THERE IS NO GUARANTEE THE INFORMATION IS REPRESENTATIVE OF THE CONDITIONS FOUND IN THE FIELD. IT IS THE RESPONSIBILITY OF THE CONTRACTOR TO VERIFY THE SITE CONDITIONS PRIOR TO ANY DEMOLITION.
- 2. EXISTING UTILITIES NOT DEMOLISHED MUST REMAIN ACTIVE AT
- 3. FULL DEPTH SAW CUT REQUIRED WHERE PAVEMENT IS PROPOSED ADJACENT TO EXISTING PAVEMENT. FOR EXISTING PAVEMENT THAT IS DAMAGED DURING REMOVALS, PAVEMENT SHALL BE REPAIRED.
- EXCAVATED EARTHWORK MATERIAL SHALL BE KEPT ON-SITE AT THE LOCATION PROVIDED BY THE AIRPORT.
- 5. CONTRACTOR SHALL TAKE SPECIAL CARE TO PREVENT THE SPREAD OF DUST AND FLYING DEBRIS THAT MAY BLOW ONTO THE ACTIVE AIRFIELD. ALL REFUSE AND DEBRIS SHALL BE CLEARED FROM THE SITE TO THE SATISFACTION OF THE CONSTRUCTION MANAGER AND SHALL BE IN ACCORDANCE OF ALL FEDERAL, STATE, AND LOCAL REQUIREMENTS.

- AND SHALL BE SALVAGED AND RESTORED TO THE EXISTING LOCATION AFTER COMPLETION OF THE PROJECT.
- 7. CONTRACTOR SHALL REMOVE EXISTING FENCE TO THE NEAREST EXISTING END POST.
- 8. CONTRACTOR SHALL REMOVE EXISTING UNDERDRAIN TO REQUIRED LENGTH IN THE FIELD TO ALLOW FOR PROJECT CONSTRUCTION.








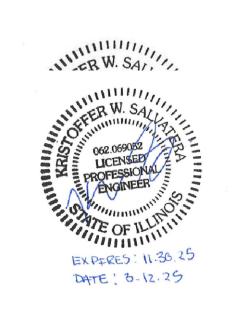

LEWIS UNIVERSITY AIRPORT

LARGE AIRCRAFT STORAGE HANGAR **405 JIM CLICK DRIVE** ROMEOVILLE, ILLINOIS

KEY PLAN

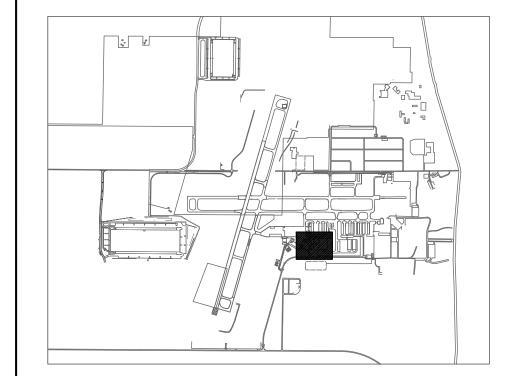

| _3_ | PERMIT REVISIONS | | | | 06/06/25 |
|------|------------------|----|-----|-------|----------|
| _2_ | PERMIT REVISIONS | | | | 05/02/25 |
| _1_ | BID ADDENDA | | | | 05/02/25 |
| No. | Description | Ву | Chk | . Арр | . Date |
| Issu | ies | | | | |

DRAWING TITLE **EXISTING CONDITIONS AND PROPOSED**

DEMOLITION PLAN

APPROVED

CHECKED


SHEET NO.

CD100

KWS


DRAWN BY JVJ

© 2007 Primera

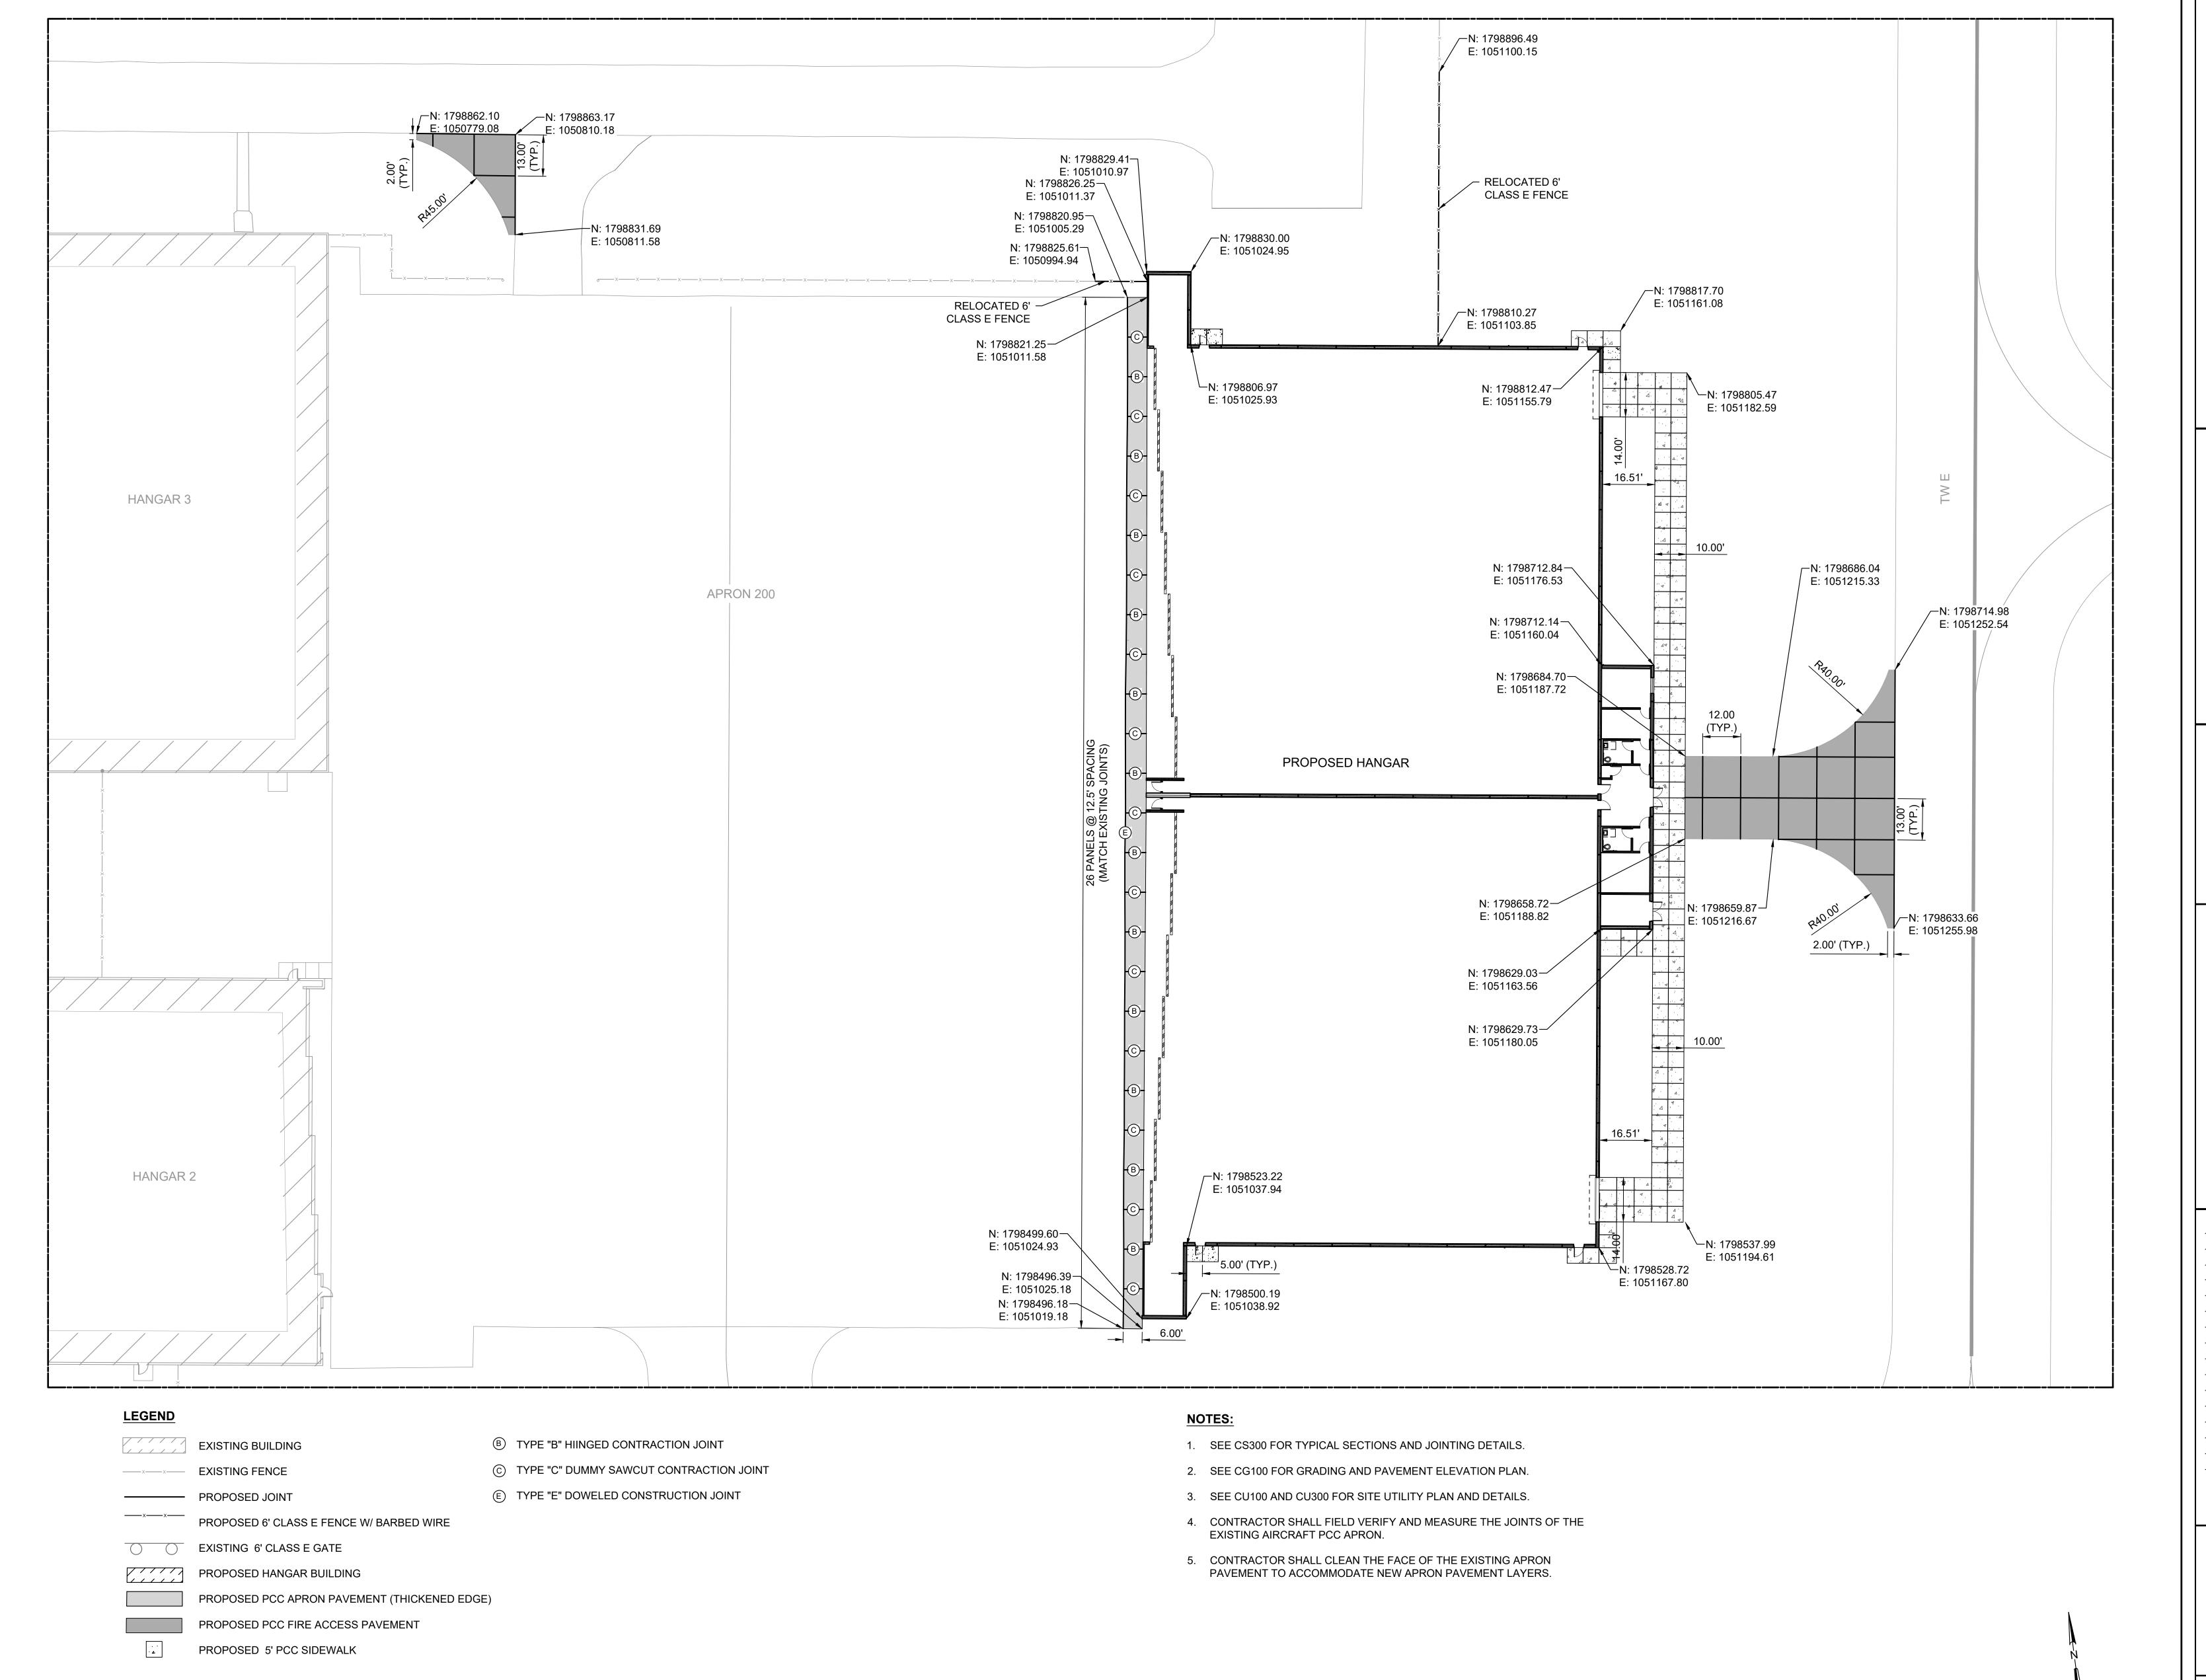


일 © 2007 Primera



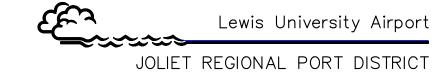




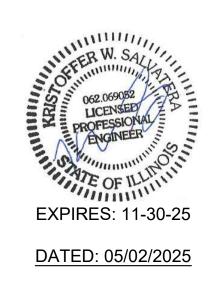

LEWIS UNIVERSITY AIRPORT

LARGE AIRCRAFT STORAGE HANGAR **405 JIM CLICK DRIVE** ROMEOVILLE, ILLINOIS

KEY PLAN

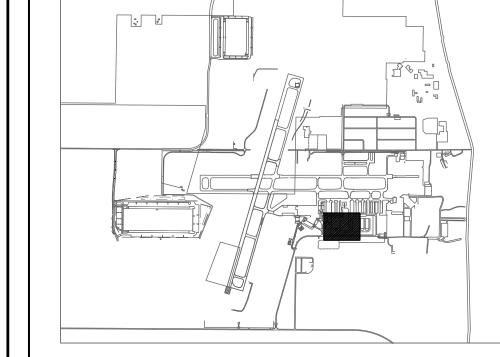

| _3_ | PERMIT REVISIONS | | | 06/06/25 |
|-----|------------------|----|----------|----------|
| _2_ | PERMIT REVISIONS | | | 05/02/25 |
| _1_ | BID ADDENDA | | | 05/02/25 |
| No. | Description | Ву | Chk. App | . Date |

DRAWING TITLE **PROPOSED PAVEMENT GEOMETRY PLAN**


APPROVED

SHEET NO.


CHECKED

DRAWN BY

CS100

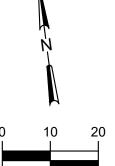


| SIGNAGE SCHEDULE | | | | | | | |
|--------------------|----------------|--|--|--|--|--|--|
| NEW SIGN NUMBER | SIGN | NOTES | | | | | |
| ROADWAY SIGN 1 | ROADWAY SIGN 1 | OFFSET 2' FROM EDGE OF SIDEWALK AND DRIVEWAY | | | | | |
| ROADWAY SIGN 2 | ROADWAY SIGN 2 | OFFSET 2' FROM EDGE OF SIDEWALK AND DRIVEWAY | | | | | |
| TAXIWAY SIGN 1 | TAXIWAY SIGN 1 | OFFSET 25' FROM EDGE OF TAXIWAY AND 10' FROM DRIVEWAY | | | | | |
| TAXIWAY SIGN 2 | TAXIWAY SIGN 2 | OFFSET 25' FROM EDGE OF TAXIWAY AND 10' FROM DRIVEWAY | | | | | |

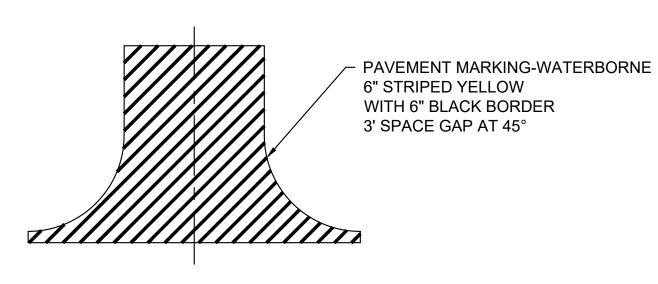


PAVEMENT MARKING DETAIL


- 1. PAINT SHALL BE FEDERAL SPECIFICATION TT-P-1952F. TYPE III.
- 2. YELLOW PAINT SHALL CONFORM TO FEDERALSTANDARD NO. 595, COLOR 33538 OR 33655.
- 3. BLACK PAINT SHALL CONFORM WITH FEDERAL STANDARD NO. 595, COLOR 37038.
- 4. YELLOW PAINT SHALL INCLUDE GLASS BEADS AND SHALL BE FEDERAL SPECIFICATION TT-B-1325D, TYPE III.

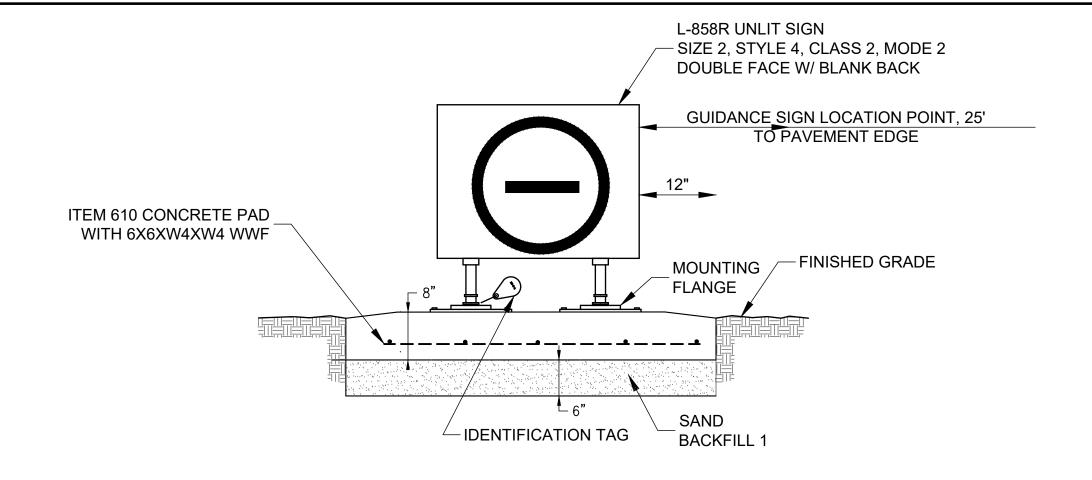

NOTES:

- 1. SIGN SHALL MEET DETAILS AS SPECIFIED IN THE PLANS FOR A MANDATORY "NO ENTRY" AIRFIELD SIGN ACCORDING TO THE FAA ADVISORY CIRCULARS NO. 150/5340-18 H "STANDARD FOR AIRPORT SIGNS" AND 150/5345-44L "SPECIFICATION FOR RUNWAY AND TAXIWAY SIGNS.
- THE CONCRETE PAD SHALL MIX SHALL MEET THE THE REQUIREMENTS OF THE ILLINOIS DEPARTMENT OF TRANSPORTATION DIVISION OF AERONAUTICS - STANDARD SPECIFICATION FOR CONSTRUCTION OF AIRPORTS, LATEST EDITION - PART 9 - MISCELLANEOUS - ITEM 610 CONCRETE FOR MISCELLANEOUS STRUCTURES.
- 3. FOR SIGN WITH ONLY ONE LEGEND FACE, SECOND LEGEND TO BE PROVIDED WITH BLANK BLACK PANEL.
- CONTRACTOR SHALL VERIFY PROPOSED SIGN LOCATIONS AND ORIENTATIONS WITH THE CONSTRUCTION MANAGER AND AIRPORT PRIOR TO INSTALLATION.

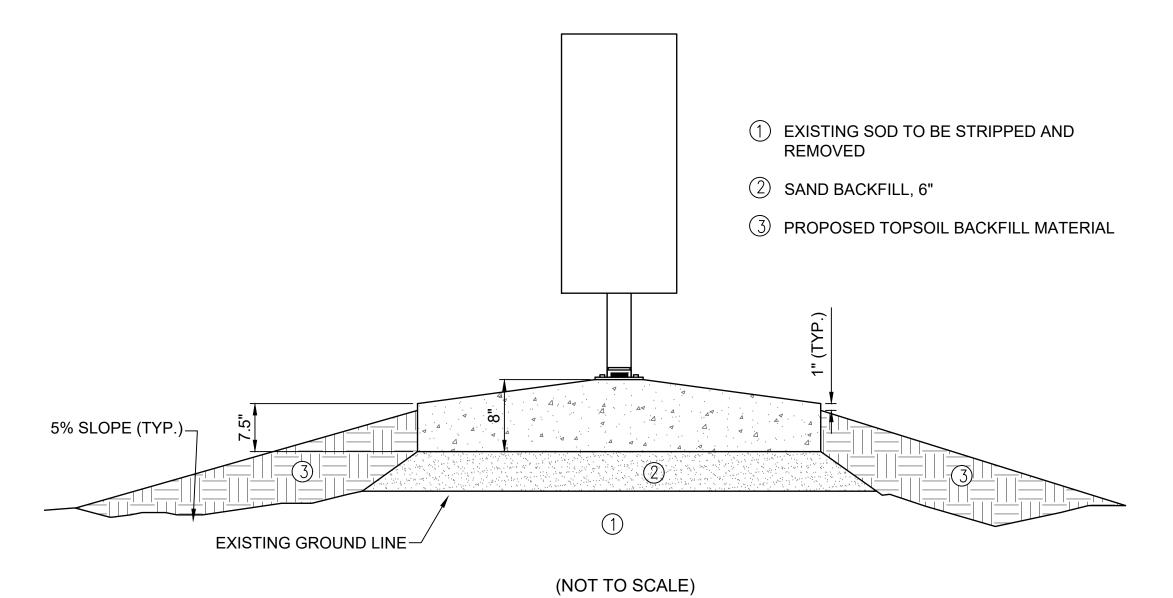

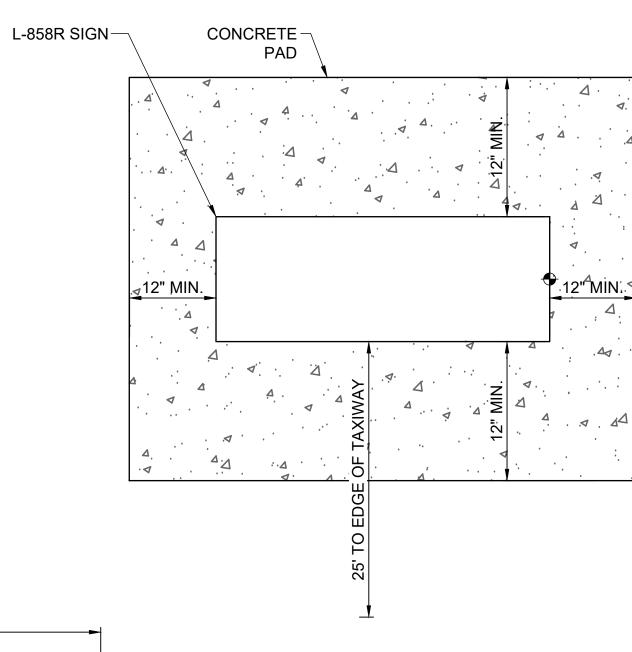




ROADWAY SIGN DETAIL

- 1. SIGN PANELS SHALL BE RETROFLECTIVE WEATHER PROOF, WITH RED LETTERING ON WHITE BACKGROUND.
- 2. SIGNS SHALL BE AFFIXED ON A GALVANIZED STRUCTURAL STEEL SIGN SUPPORT AT A HEIGHT OF 60" FROM TOP OF SIGN TO THE GROUND LEVEL.



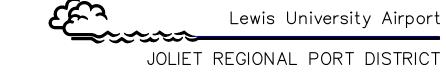






DATED: 05/02/2025

LEWIS UNIVERSITY AIRPORT

LARGE AIRCRAFT STORAGE HANGAR 405 JIM CLICK DRIVE ROMEOVILLE, ILLINOIS

KEY PLAN

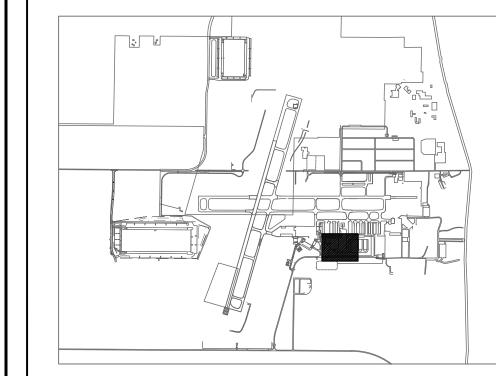

| 3 | PERMIT REVISIONS | | | | 06/06/25 |
|------|------------------|----|------|-----|----------|
| 2 | PERMIT REVISIONS | | | | 05/02/25 |
| 1 | BID ADDENDA | | | | 05/02/25 |
| Vo. | Description | Ву | Chk. | App | Date |
| lssu | es | - | | | |

PROPOSED AIRFIELD SIGNAGE AND MARKING PLAN

APPROVED
RMH
CHECKED

SHEET NO.


CS101

DRAWN BY

JVJ

TYPICAL SECTION - PCC APRON PAVEMENT (LOOKING NORTH)


- ① PROPOSED 6-INCH TO 9-INCH PORTLAND CEMENT CONCRETE (PCC) THICKENED EDGE
- 2 PROPOSED 6-INCH AGGREGATE BASE COURSE
- ③ PROPOSED 6-INCH CRUSHED AGGREGATE DRAINAGE SUBBASE
- 4 PROPOSED SEPARATION FABRIC

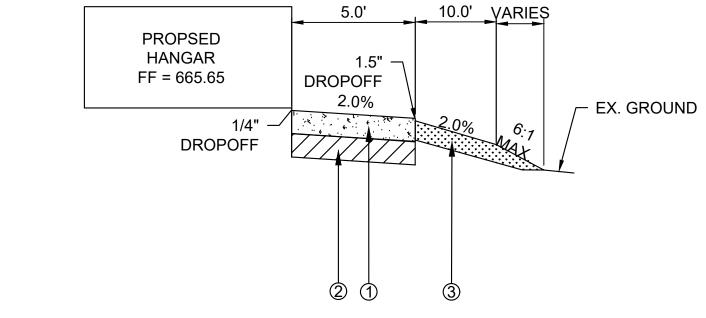


1. 6"X6"-2.9XW.9 WELDED WIRE MESH SHALL BE PLACED ALONG THE ENTIRE SIDEWALK

TYPICAL SECTION - PCC SIDEWALK

- 1) PROPOSED 6-INCH PORTLAND CEMENT CONCRETE (PCC)
- PROPOSED 4-INCH AGGREGATE BASE COURSE
- (3) PROPOSED 6-INCH TOPSOIL

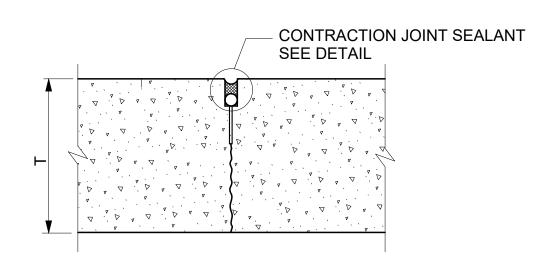

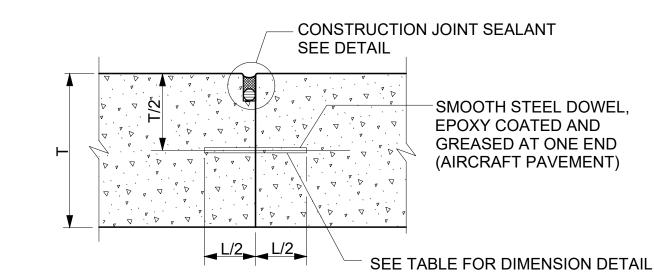

4-INCH SLUMP, WITH A MINIMUM COMPRESSIVE


TYPICAL SECTION - PCC FIRE ACCESS PAVEMENT

1 PROPOSED 6-INCH PORTLAND CEMENT CONCRETE (PCC)

② PROPOSED 6-INCH AGGREGATE BASE COURSE

STRENGTH OF 4000 PSI.

③ PROPOSED 6-INCH TOPSOIL

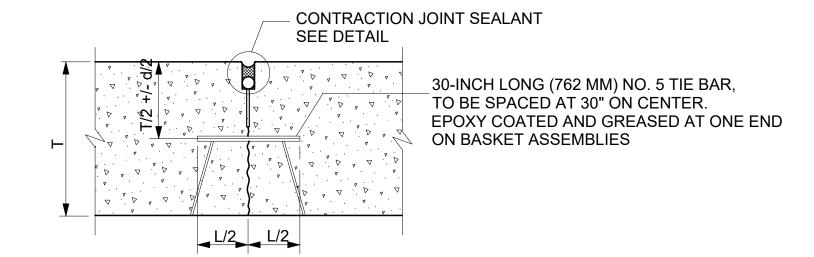

TOP OF SEALANT

1/4" - 3/8" BELOW

FOAM BACKER ROD

FILLER MATERIAL


P.C.C. PAVEMENT

PRE MOLDED CLOSED

CELL FLEXIBLE FOAM JOINT

JET FUEL RESISTANT SEALANT

PAVEMENT

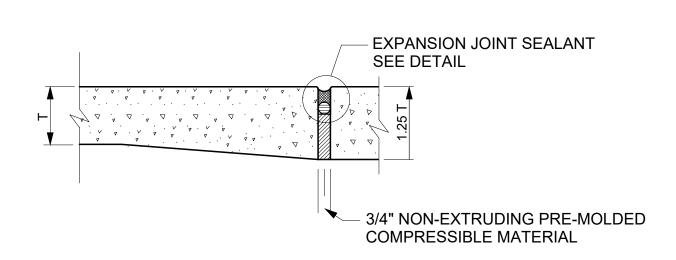



THICKENED EDGE EXPANSION JOINT ADJACENT TO EXISTING PAVEMENT

SEE STRUCTURAL SHEETS FOR DETAIL TRANSITIONS TO INTERIOR


CONCRETE SLAB.

DUMMY SAWCUT CONTRACTION JOINT

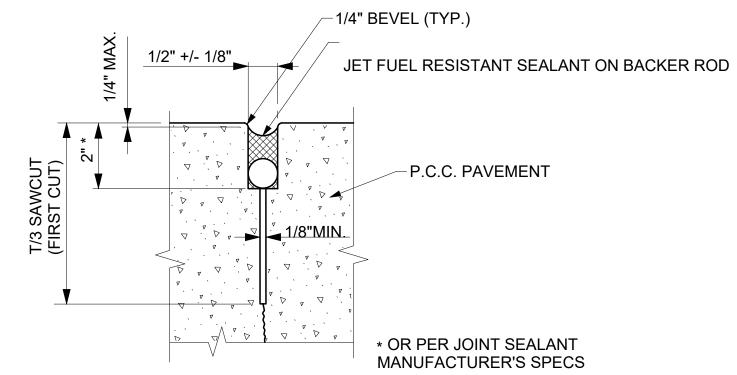

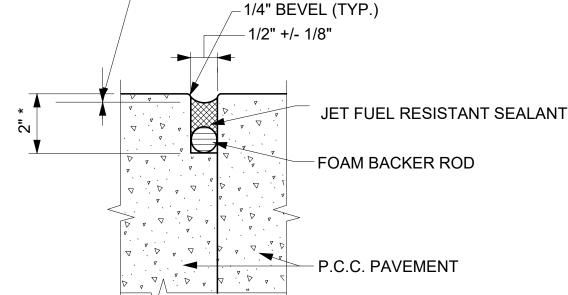

- SEE NOTE

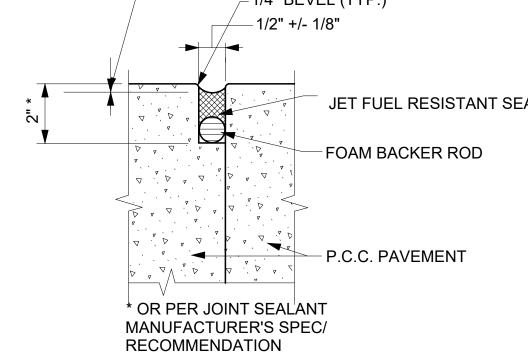

DOWELED CONSTRUCTION JOINT

CONSTRUCTION JOINT SEALANT


TOP OF SEALANT 1/4" - 3/8" BELOW PAVEMENT

EXPANSION JOINT SEALANT

SEALANT USED


HINGED CONTRACTION JOINT


5/8"[∨]TO 3/4" DIA. CLOS ED CELL BACKER ROD COMPATIBLE WITH

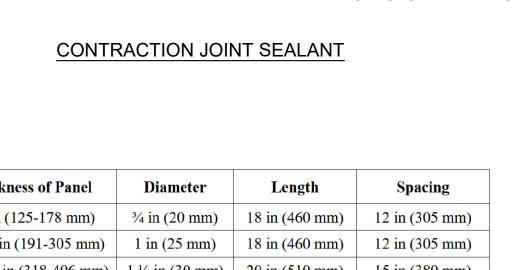


| Thickness of Panel | Diameter | Length | Spacing |
|-------------------------|----------------|----------------|----------------|
| 5-7 in (125-178 mm) | 3/4 in (20 mm) | 18 in (460 mm) | 12 in (305 mm) |
| 7.5-12 in (191-305 mm) | 1 in (25 mm) | 18 in (460 mm) | 12 in (305 mm) |
| 12.5-16 in (318-406 mm) | 1 ¼ in (30 mm) | 20 in (510 mm) | 15 in (380 mm) |
| 16.5-20 in (419-508 mm) | 1 ½ in (40 mm) | 20 in (510 mm) | 18 in (460 mm) |
| 20.5-24 in (521-610 mm) | 2 in (50 mm) | 24 in (610 mm) | 18 in (460 mm) |

T = 6.0"

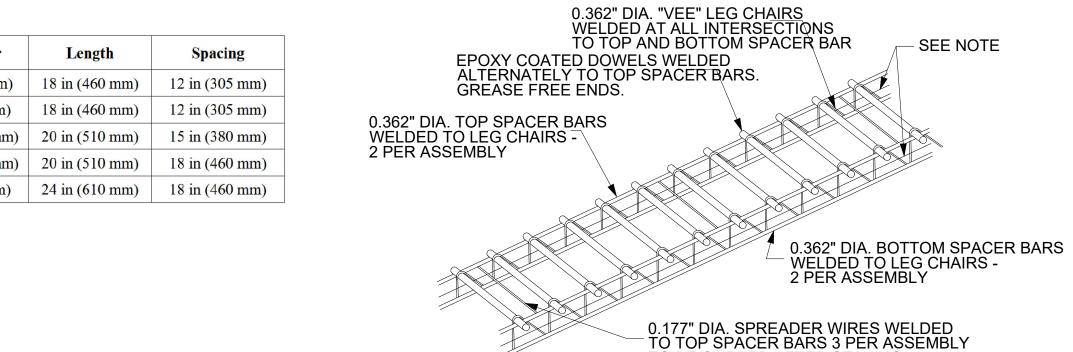

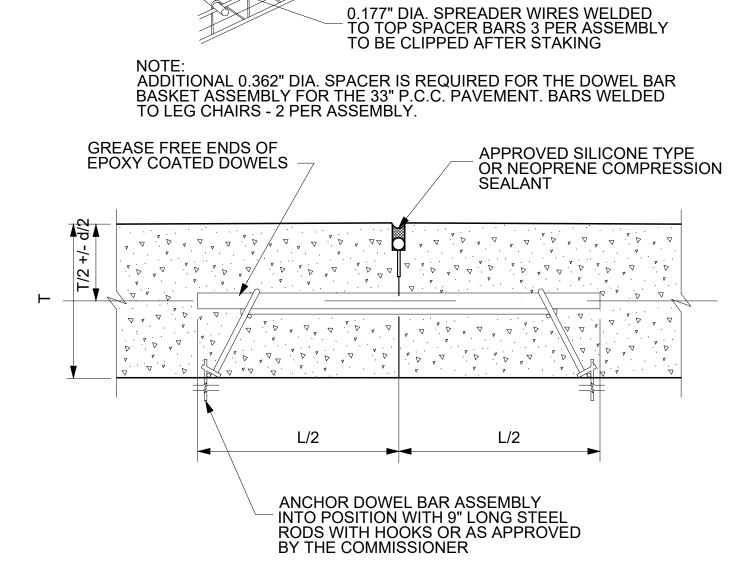

TYPICAL DOWEL BAR ASSEMBLY

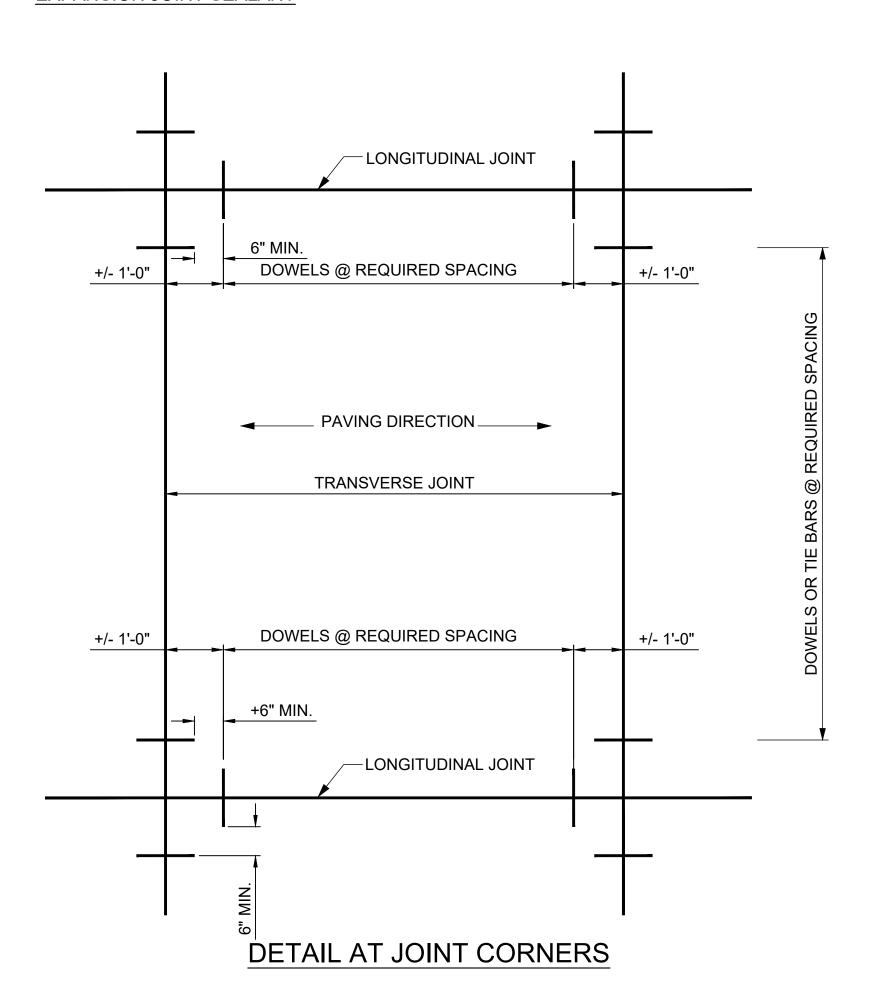

LEWIS UNIVERSITY AIRPORT

LARGE AIRCRAFT STORAGE HANGAR **405 JIM CLICK DRIVE** ROMEOVILLE, ILLINOIS

550 WEST JACKSON BLVD., SUITE 600, CHICAGO, ILLINOIS 60661

Lewis University Airport

JOLIET REGIONAL PORT DISTRICT

BUILDING SOLUTIONS

PERMIT REVISIONS ____ 05/02/25 PERMIT REVISIONS BID ADDENDA By Chk. App. Date No. Description Issues


DRAWING TITLE

TYPICAL SECTIONS AND PAVEMENT **JOINTING DETAILS**

APPROVED CHECKED

SHEET NO.

CS300 DRAWN BY

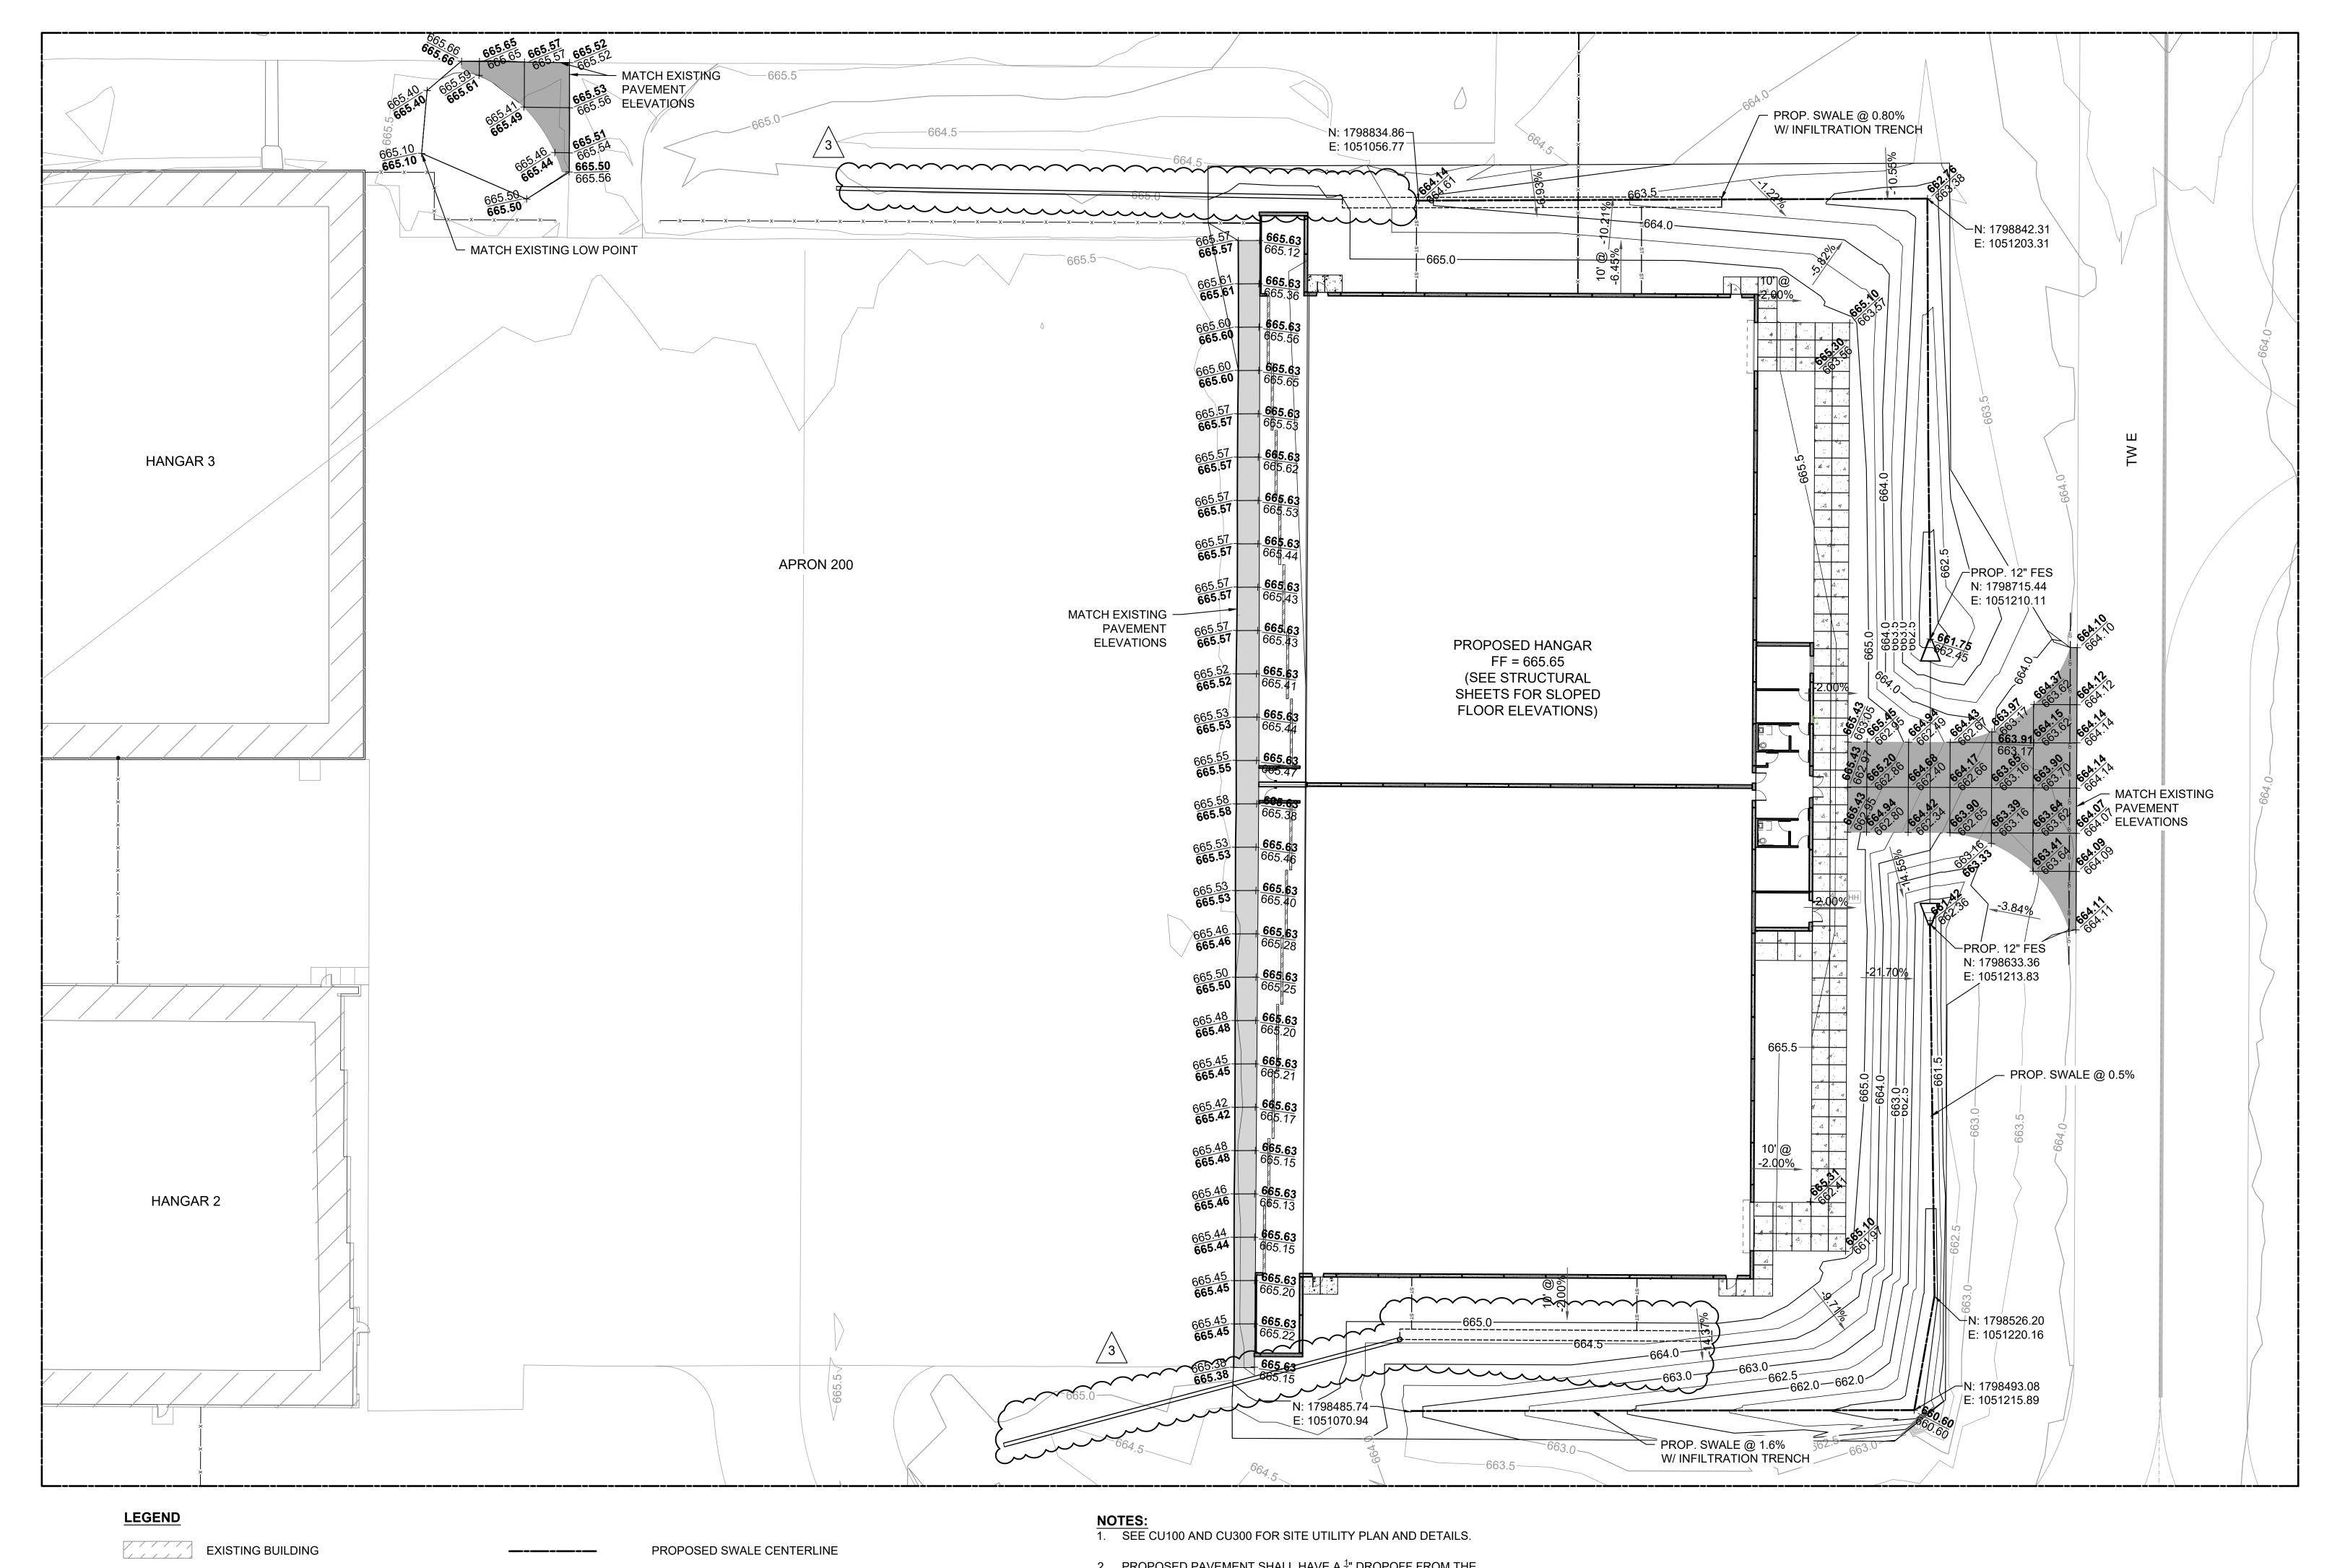

EXISTING MINOR CONTOUR (0.5' INTERVAL)

EXISTING MAJOR CONTOUR (1' INTERVAL)

PROPOSED MINOR CONTOUR (0.5' INTERVAL)

PROPOSED MAJOR CONTOUR (1' INTERVAL)

PROPOSED/EXISTING SPOT ELEVATION

—— XXX.5 —

—— XXX.0 ——

—— XXX.5 —

—— XXX.0 ——

EXISTING FENCE

——×——×— PROPOSED 6' CLASS E FENCE W/ BARBED WIRE


PROPOSED PCC APRON PAVEMENT

PROPOSED PCC SIDEWALK PAVEMENT


PROPOSED PCC FIRE ACCESS PAVEMENT

- 2. PROPOSED PAVEMENT SHALL HAVE A $\frac{1}{4}$ " DROPOFF FROM THE PROPOSED HANGAR FINISHED FLOOR.
- PROPOSED TURF SHALL HAVE A 1.5" DROPOFF FROM PROPOSED PAVEMENT OR 3" DROPOFF FROM THE PROPOSED HANGAR FINISHED FLOOR.



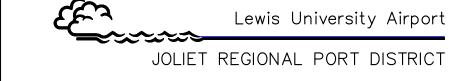




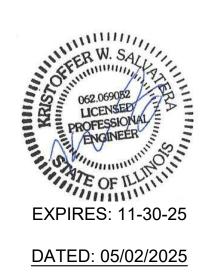

LEWIS UNIVERSITY AIRPORT

LARGE AIRCRAFT STORAGE HANGAR 405 JIM CLICK DRIVE ROMEOVILLE, ILLINOIS

KEY PLAN

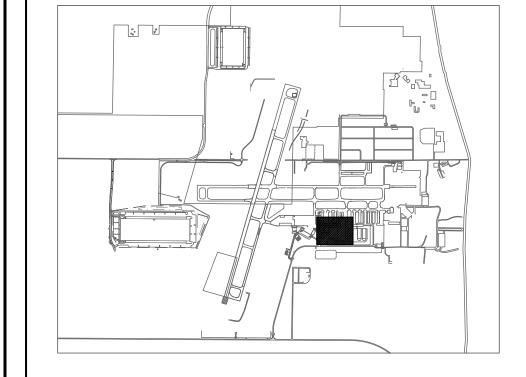

| 3 | PERMIT REVISIONS | | | | 06/06/25 |
|------|------------------|----|------|-----|----------|
| 2_ | PERMIT REVISIONS | | | | 05/02/25 |
| 1_ | BID ADDENDA | | | | 05/02/25 |
| No. | Description | Ву | Chk. | App | Date |
| lssu | | | | | |
| 1000 | | | | | |
| | | | | | |

GRADING AND
PAVEMENT
ELEVATION PLAN

APPROVED RMH

CHECKED

DRAWN BY


SHEET NO.

CG100

0 10 20



EARTHWORK SUMMARY TABLE 8" TOPSOIL 6" TOPSOIL PLACEMENT EXCESS TOPSOIL CUT FILL STRIPPING AVG. LOCATION **BORROWED EXCAVATION** (CUBIC YARDS) (CUBIC YARDS) (CUBIC YARDS) (CUBIC YARDS) (CUBIC YARDS) (CUBIC YARDS) FILL SITE GRADING 423.9 3636.7 3212.7 1974.7

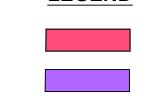

CUT AREA

EXISTING CONTOUR

PROPOSED CONTOUR

EARTHWORK NOTES

1. EARTHWORK QUANTITIES ARE BASED ON CALCULATED MATERIALS IN ITS INITIAL OR FINAL POSITION AS SHOWN IN THE PLANS.

2. QUANTITIES FOR REMOVAL OR PLACEMENT OF UNDERGROUND UTILITIES IS NOT INCLUDED IN THE EARTHWORK SUMMARY. MATERIAL EXCAVATION OR FILL FOR UNDERGROUND UTILITIES SHALL BE CONSIDERED BY THE CONTRACTOR AND INCLUDED IN THE CONTRACT PRICE.

3. ALL EXCESS TOPSOIL AND EMBANKMENT SHALL BE STORED WITHIN THE AIRPORT PROPERTY AS DIRECTED BY THE AIRPORT MANAGER.

4. IF THE CONTRACTOR ENCOUNTERS UNSUITABLE OR CONTAMINATED SOILS WITHIN THE SITE, MATERIAL SHALL BE UNUSABLE AS EMBANKMENT FILL, AND SHALL BE STOCKPILED WITHIN THE AIRPORT PROPERTY AS DIRECTED BY THE AIRPORT MANAGER OR OWNER REPRESENTATIVE.

5. REFER TO THE STRUCTURAL SHEETS FOR EARTH MOVING EXCAVATION OR EMBANKMENT MATERIALS SUITABLE FOR PROPOSED STRUCTURES.










LEWIS UNIVERSITY AIRPORT

LARGE AIRCRAFT STORAGE HANGAR **405 JIM CLICK DRIVE** ROMEOVILLE, ILLINOIS

KEY PLAN

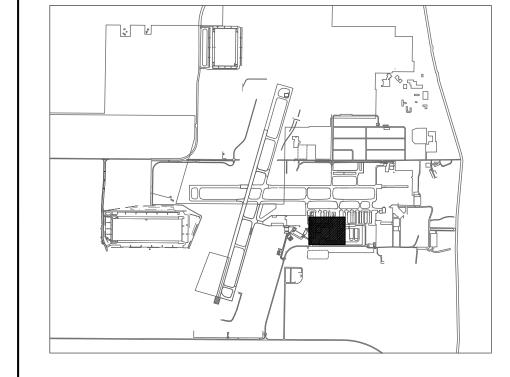


| _3_ | PERMIT REVISIONS | | | | 06/06/25 |
|------|------------------|----|------|-----|----------|
| _2_ | PERMIT REVISIONS | | | | 05/02/25 |
| 1 | BID ADDENDA | | | | 05/02/25 |
| No. | Description | By | Chk. | App | . Date |
| Issu | ies | | | | |


DRAWING TITLE **EARTHWORK** SUMMARY TABLE

APPROVED CHECKED

SHEET NO.

CG101 DRAWN BY

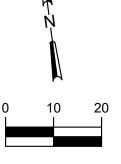

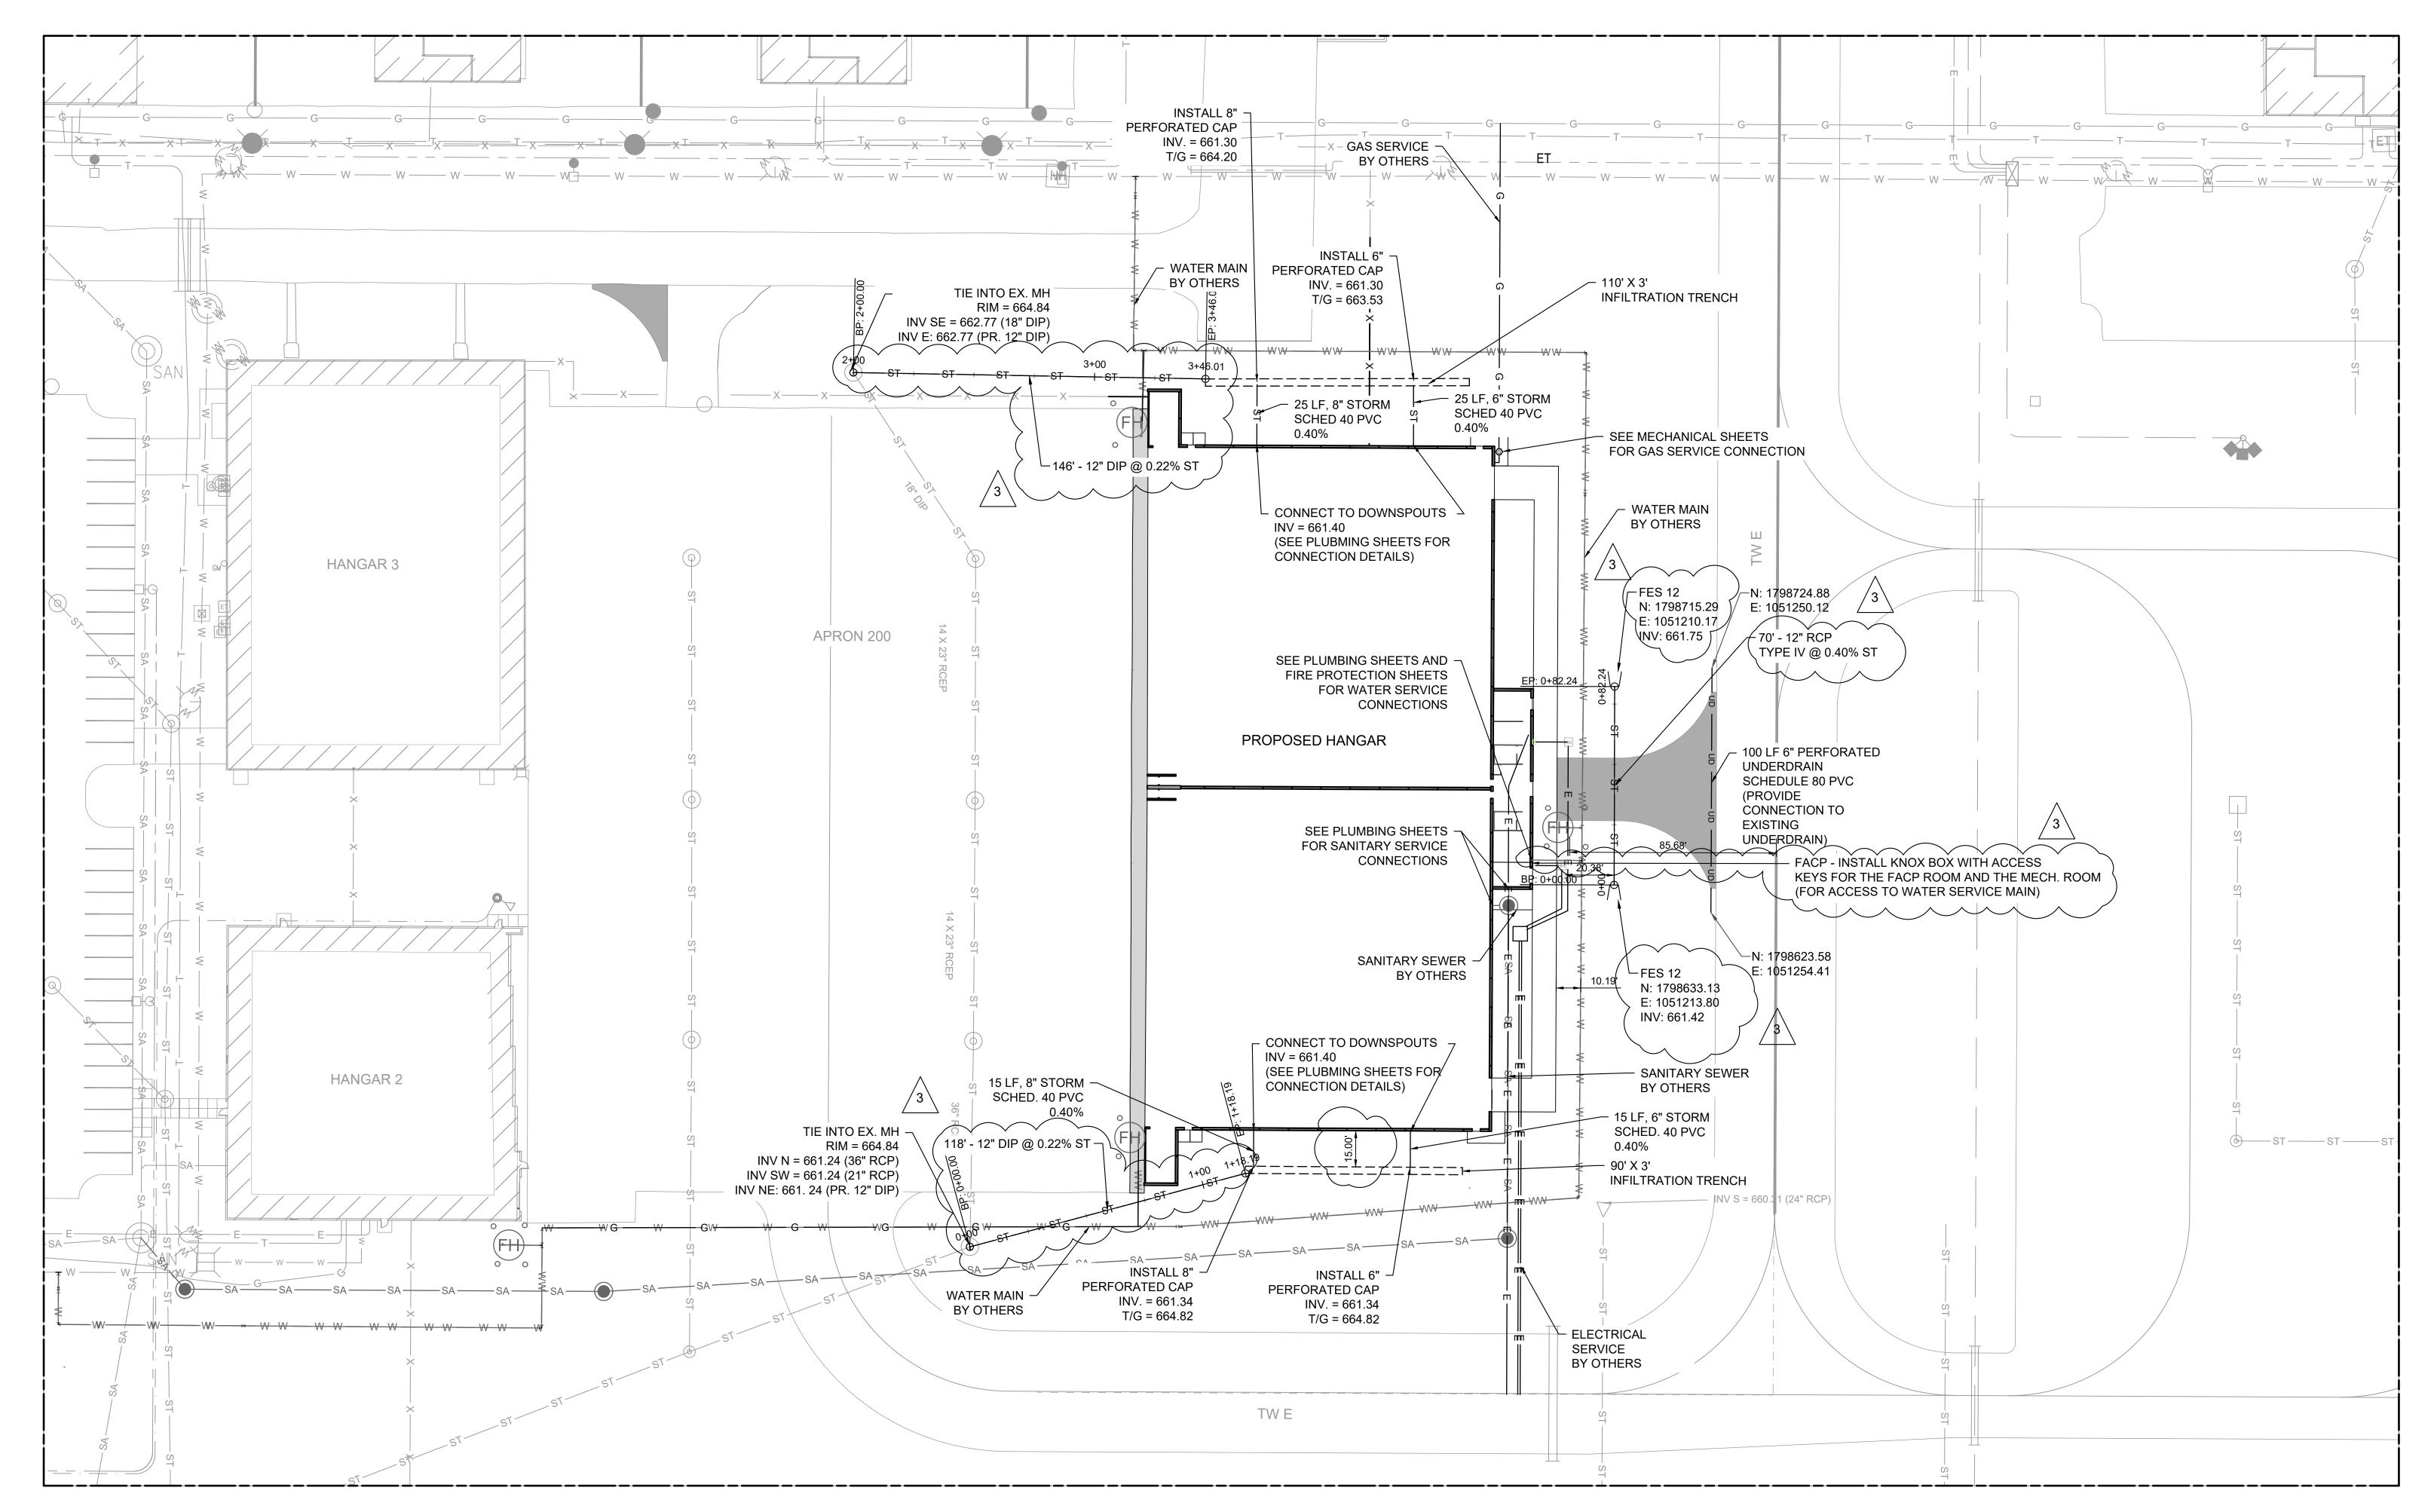

LEGEND

EXISTING BUILDING

——X—— EXISTING FENCE

EXISTING 6' CLASS E GATE

PROPOSED HANGAR BUILDING

PROPOSED PCC APRON PAVEMENT PROPOSED FIRE ACCESS PAVEMENT

PROPOSED SIDEWALK PAVEMENT

——ST — PROPOSED STORM SEWER

— UD — PROPOSED UNDERDRAIN

PROPOSED FLARED END SECTION (FES)

PROPOSED WATER MAIN (BY OTHERS)

PROPOSED SANITARY SEWER (BY OTHERS)

——G—— PROPOSED GAS (BY OTHERS)

——E—— PROPOSED ELECTRICAL (SEE ELECTRICAL E-SERIES SHEETS)

GENERAL NOTES:

1. SEE CD100 FOR EXISTING UTILITY LEGEND.

2. SEE CU300 FOR SITE UTILITY DETAILS.

3. SEE CE100 AND CE300 FOR PROPOSED EROSION AND SEDIMENT CONTROL PLAN AND DETAILS.

DEMOLITION AND CONSTRUCTION.

4. CONTRACTOR SHALL VERIFY ALL UTILITIES WITHIN THE SITE PRIOR TO

5. AT THE END OF THE WORK DAY, CONTRACTOR SHALL PROVIDE POSITIVE DRAINAGE OR DEWATERING ACTIVITIES FROM THE SITE.

6. UTILITY SEPARATION CLEARANCES SHALL BE MAINTAINED PER LOCAL

7. CONTRACTOR SHALL COORDINATE WITH THE CMR FOR COORDINATION WITH THE ADJACENT PROJECT FOR: "WATER AND SEWER MAIN EXTENSIONS IN THE SOUTH TERMINAL."

STORM SEWER NOTES:

1. STORM SEWER SHALL BE REINFORCED CONCRETE PIPE MEETING ASTM SPECIFICATION C-76.

2. PIPE JOINTS SHALL MEET ASTM SPECIFICATIONS C-361 FOR REINFORCED CONCRETE LOW HEAD PRESSURE PIPE AND SHALL EITHER BE CONFINED "O-RING" OR "TYLOK" FOR THE GASKET MATERIAL.

3. FRAME AND LIDS SHALL BE EAST JORDAN IRON WORKS (EJIW) #1050Z1 FRAME WITH #1020A HD LID EMBOSSED WITH "STORM" AND "VILLAGE OF ROMEOVILLE."

GAS NOTES:

1. CONTRACTOR SHALL COORDINATE THE NEW GAS SERVICE LINE AND METER LOCATION WITH NICOR.

ELECTRIC NOTES:

1. SEE ELECTRICAL SHEETS (E-SERIES) FOR ELECTRICAL WORK TO BE COMPLETED OUTSIDE OF THE NEW BUILDING.

2. CONTRACTOR SHALL COORDINATE NEW ELECTRIC SERVICE FROM THE NEW BUILDING THE EXISTING TRANSFORMER WITH COMED.

SANITARY SEWER NOTES:

1. CONTRACTOR SHALL COORDINATE NEW SANITARY CONNECTIONS WITH THE SANITARY SEWER CONTRACTOR.

2. PRIOR TO SANITARY SEWER SERVICE CONNECTION, ALL LOCAL-MUNICIPAL REGULATIONS SHALL BE MET ACCORDING TO THE VILLAGE OF ROMEOVILLE.

WATER MAIN NOTES:


1. CONTRACTOR SHALL COORDINATE NEW WATER CONNECTIONS WITH THE SANITARY SEWER CONTRACTOR.

2. PRIOR TO WATER MAIN SERVICE CONNECTION, ALL LOCAL-MUNICIPAL AND FIRE CODE REGULATIONS SHALL BE MET ACCORDING TO THE VILLAGE OF ROMEOVILLE.

BUILDING UTILITY SUBCONTRACTORS UNDER THIS CONTRACT, INCLUDING BUT NOT LIMITED TO, MECHANICAL, PLUMBING, FIRE PROTECTION, AND CIVIL/DRAINAGE CONTRACTORS, SHALL EXTEND ALL BUILDING UNDERGROUND PIPING EXITING THE BUILDING FOR A DISTANCE OF AT LEAST FIVE FEET FROM THE OUTER BUILDING WALL FACE, OR IN THE CASE OF JOINTED PIPE, TO THE NEXT FULL-SECTION JOINT BEYOND FIVE FEET. ALL OPEN ENDS SHALL BE SEALED/WEATHER-PROOFED BEFORE THEIR BACKFILL. THE BUILDING CONTRACTOR SHALL ALSO VERIFY TO THE SATISFACTION OF THE CONSTRUCTION MANAGER AND ENGINEER THAT ALL INVERT ELEVATIONS AT THE PIPE END(S) ARE AT THE REQUIRED ELEVATION AND WILL PERMIT CONNECTION OF THE BUILDING PIPE TO THE ASSOCIATED MAINLINE UTILITY WITHOUT ANY FURTHER ADJUSTMENT. BUILDING SUBCONTRACTORS SHALL COORDINATE ALL OF ASPECTS OF THEIR WORK WITH THE MAINLINE WATER/SEWER MAIN WORK BY OTHERS. THERE WILL BE NO ADDITIONAL PAYMENT FOR ANY ADJUSTMENTS SUBSEQUENTLY REQUIRED TO MAKE THE FINAL CONNECTIONS BY OTHERS

"I, KRIS SALVATERA, P.E., HEREBY CERTIFY THAT ADEQUATE STORM WATER STORAGE AND DRAINAGE CAPACITY HAS BEEN PROVIDED FOR THIS DEVELOPMENT, SUCH THAT SURFACE WATER FROM THE DEVELOPMENT WILL NOT BE DIVERTED ONTO AND CAUSE DAMAGE TO ADJACENT PROPERTY FOR STORMS UP TO AND INCLUDING THE ONE HUNDRED (100) YEAR EVENT, AND THAT THE DESIGN PLANS ARE IN COMPLIANCE WITH ALL APPLICABLE STATE, COUNTY, AND VILLAGE ORDINANCES."



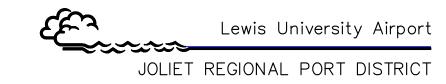






LEWIS UNIVERSITY AIRPORT

LARGE AIRCRAFT STORAGE HANGAR **405 JIM CLICK DRIVE** ROMEOVILLE, ILLINOIS

KEY PLAN

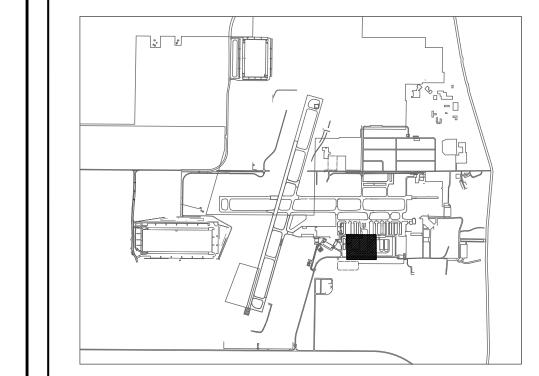

| | | | | |
|----|------------------|------|------|----------|
| | | | | |
| | | · | | |
| | | | | |
| | | | | |
| | | | | |
| | | | | |
| | | · —— | | |
| | | · —— | | |
| | | | | |
| | | | | |
| | | | | |
| | | · | | |
| | | | | |
| 3_ | PERMIT REVISIONS | | | 06/06/25 |
| 2 | PERMIT REVISIONS | | | 05/02/25 |
| 1 | BID ADDENDA | | | 05/02/25 |
| | | | | |

DRAWING TITLE SITE UTILITY PLAN

No. Description

Issues

APPROVED

SHEET NO.


CU100

By Chk. App. Date

CHECKED KWS

DRAWN BY JVJ


PROFILE VIEW OF SOUTH INFILTRATION TRENCH OUTLET

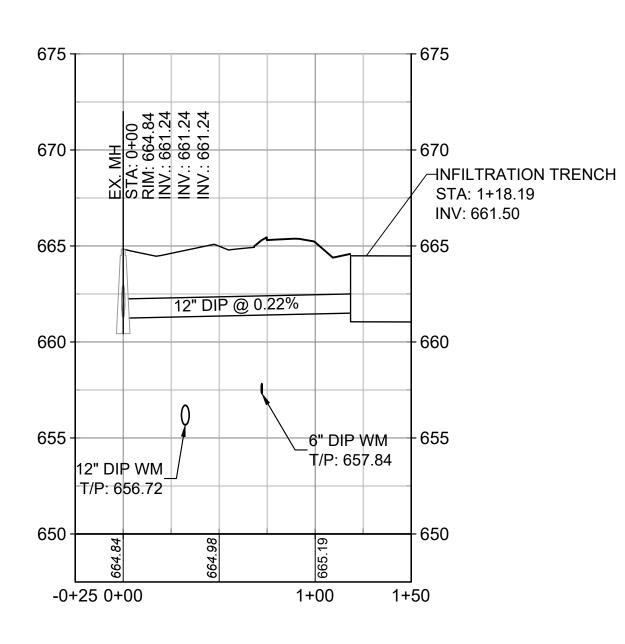

INSTALL END SECTION

METAL GRATE

PROFILE VIEW OF NORTH INFILTRATION TRENCH OUTLET

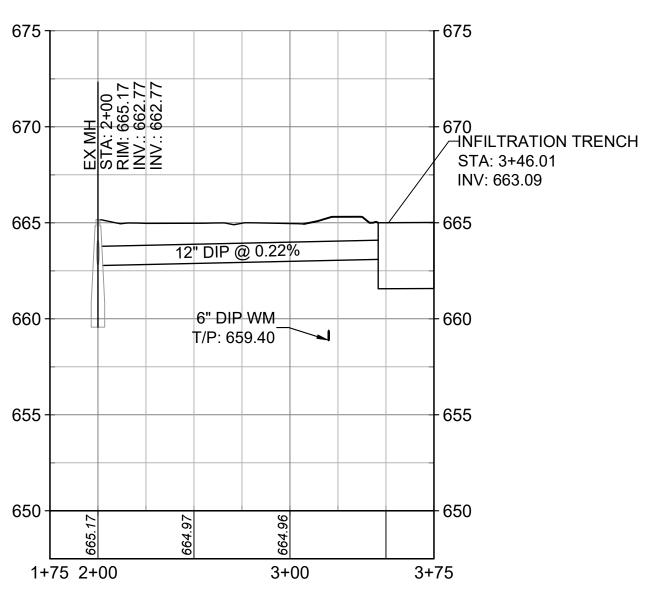

COMPACTED CA-6 BEDDING MATERIAL IN ACCORDANCE WITH SPECIFICATIONS-COMPACTION TO 90% STANDARD PROCTOR

COMPACTED SELECT

EARTH BACKFILL. SEE

SPECIFICATIONS

FINISHED GRADE

PVC STORM DRAIN

W/ PERFORATED

END CAP

NEW 6" TOPSOIL

INFILTRATION TRENCH

BEDDING SHALL BE REMOVED AND REPLACED.

FINISHED ·

2. DO NOT COMPACT SOIL PLACED ABOVE AGGREGATE.

1. UNSUITABLE MATERIAL ENCOUNTERED DURING PLACEMENT OF

UNDER UNPAVED AREAS UNDER FUTURE PAVED

8" OVERLAP FILTER FABRIC

6" CA-16 COARSE AGGREGATE

PERMEABLE AGGREGATE BASE, OPEN-GRADED, CRUSHED

- FILTER FABRIC ENVELOPE (SEE

ANGULAR STONE, IDOT CA-3

SPECIFICATIONS) SAND FILTER, IDOT FA-2

PAVEMENT SECTION

(SEE TYPICAL SECTIONS)

- SUBGRADE

COMPACTED CA-6 GRANULAR

TRENCH BACKFILL. SEE

SPECIFICAITONS. COST INCIDENTAL TO PIPE.

COMPACTION

— DRAINAGE PIPE

95% STANDARD PROCTOR


CHOKING STONE, OPEN GRADED MEDIUM

- 1. UNSUITABLE MATERIAL ENCOUNTERED DURING PLACEMENT OF BEDDING SHALL BE REMOVED AND REPLACED.
- 2. WITHIN 3 FEET OF FUTURE PAVED AREA, GRANULAR BACKFILL IS TO BE USED INSTEAD OF EARTH BACKFILL.


O.D. + 2'-0"

3. AT CONTRACTOR'S OPTION IDOT CONTROLLED LOW STRENGTH MATERIAL WITH A HIGH EARLY STRENGTH, "FLASH FILL", MAY BE USED INSTEAD OF GRANULAR TRENCH BACKFILL UNDER PAVEMENTS.

PIPE TRENCH

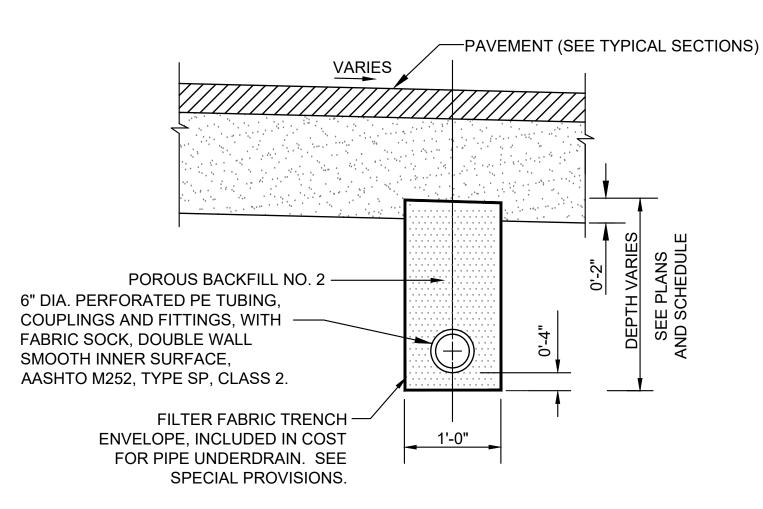


UNDERDRAIN UNDER PAVEMENT

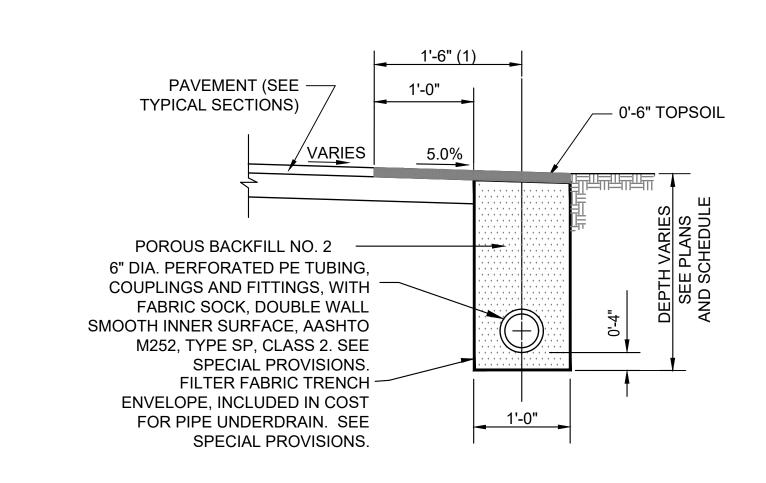

UNDERDRAIN ALONG PAVEMENT EDGE



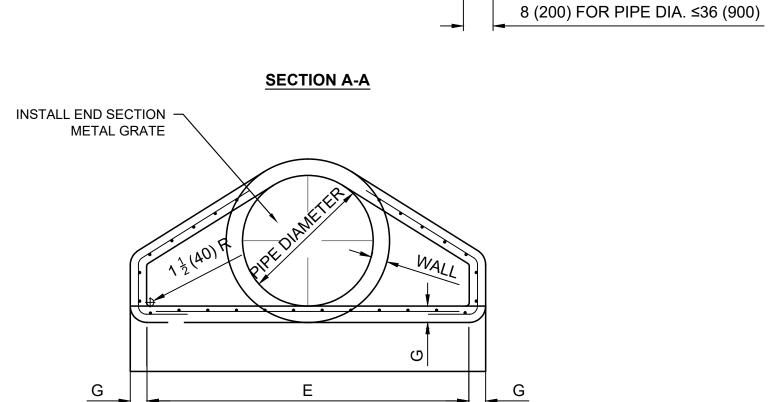

4 (100)


7:::::

END VIEW

| PIPE DIA. | APPROX. QTY. LBS (KG) | WALL | А | В | С | D | E | G | R | APPROX. SLOPE |
|-------------|-----------------------------|-----------|------------|-------------|--|--|-------------|-----------|------------|------------------|
| 12 (300) | 530 (240) | 2 (51) | 4 (102) | 24 (610) | 4'-0 ⁷ / ₈ " (1.241M) | 6'-0 ⁷ / ₈ " (1.851M) | 24 (610) | 2 (51) | 9 (229) | 1:2.4 |

*RADIUS AS FURNISHED BY MANUFACTURER

PRECAST REINFORCED CONCRETE END SECTION (IDOT STANDARD 542301-03)

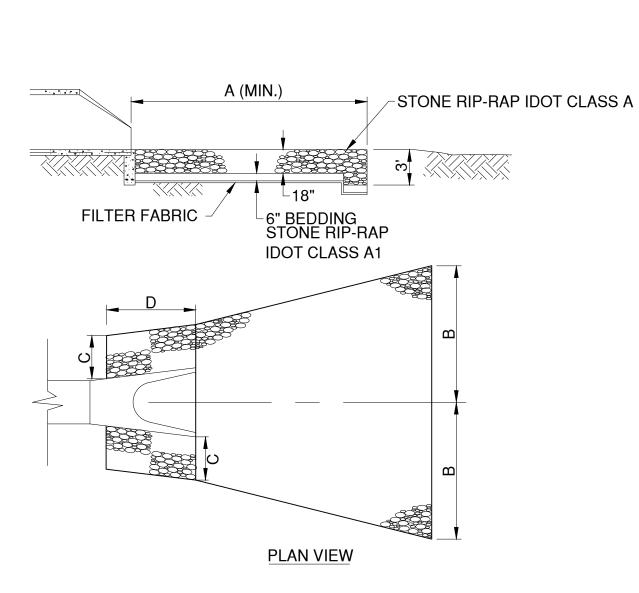

| INSIDE DIAMETER STORM SEWER | М | IN. DIM | ENSION | I (FT) | ROCK RIP RAP SIZE |
|--------------------------------|----|---------|--------|---------------|----------------------|
| (IN.) | Α | В | С | D | IDOT GRADATION |
| 12" thru 24" | 15 | 4 | 1.5 | 4 | RR-3 |

IF NO DIMENSIONS SHOWN ON PLANS, USE DIMENSIONS FROM TABLE.


MAINTENANCE NOTES:

- 1. INSPECT RIP RAP AFTER STORM EVENTS FOR STONE DISPLACEMENT AND FOR EROSION AT THE SIDES AND ENDS OF THE APRON.
- 2. TAKE NEEDED REPAIRS IMMEDIATELY; USE APPROPRIATE SIZE STONE, AND
- 3. THE ENGINEER SHALL DETERMINE THE FINAL RIP-RAP CONFIGURATION IN THE FIELD.

RIP RAP AT END SECTIONS

DO NOT PLACE THEM ABOVE FINISHED GRADE.

550 WEST JACKSON BLVD., SUITE 600, CHICAGO, ILLINOIS 60661

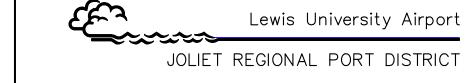






LEWIS UNIVERSITY AIRPORT

LARGE AIRCRAFT STORAGE HANGAR 405 JIM CLICK DRIVE ROMEOVILLE, ILLINOIS

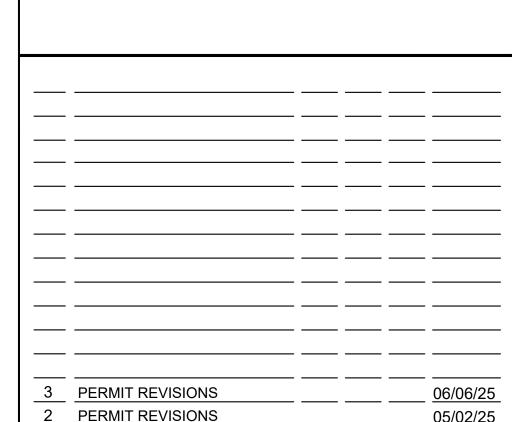

DRAWING TITLE SITE UTILITY **DETAILS**

BID ADDENDA

No. Description

KWS

DRAWN BY JVJ

Issues


APPROVED CHECKED

CU300

SHEET NO.


By Chk. App. Date

NOT TO SCALE

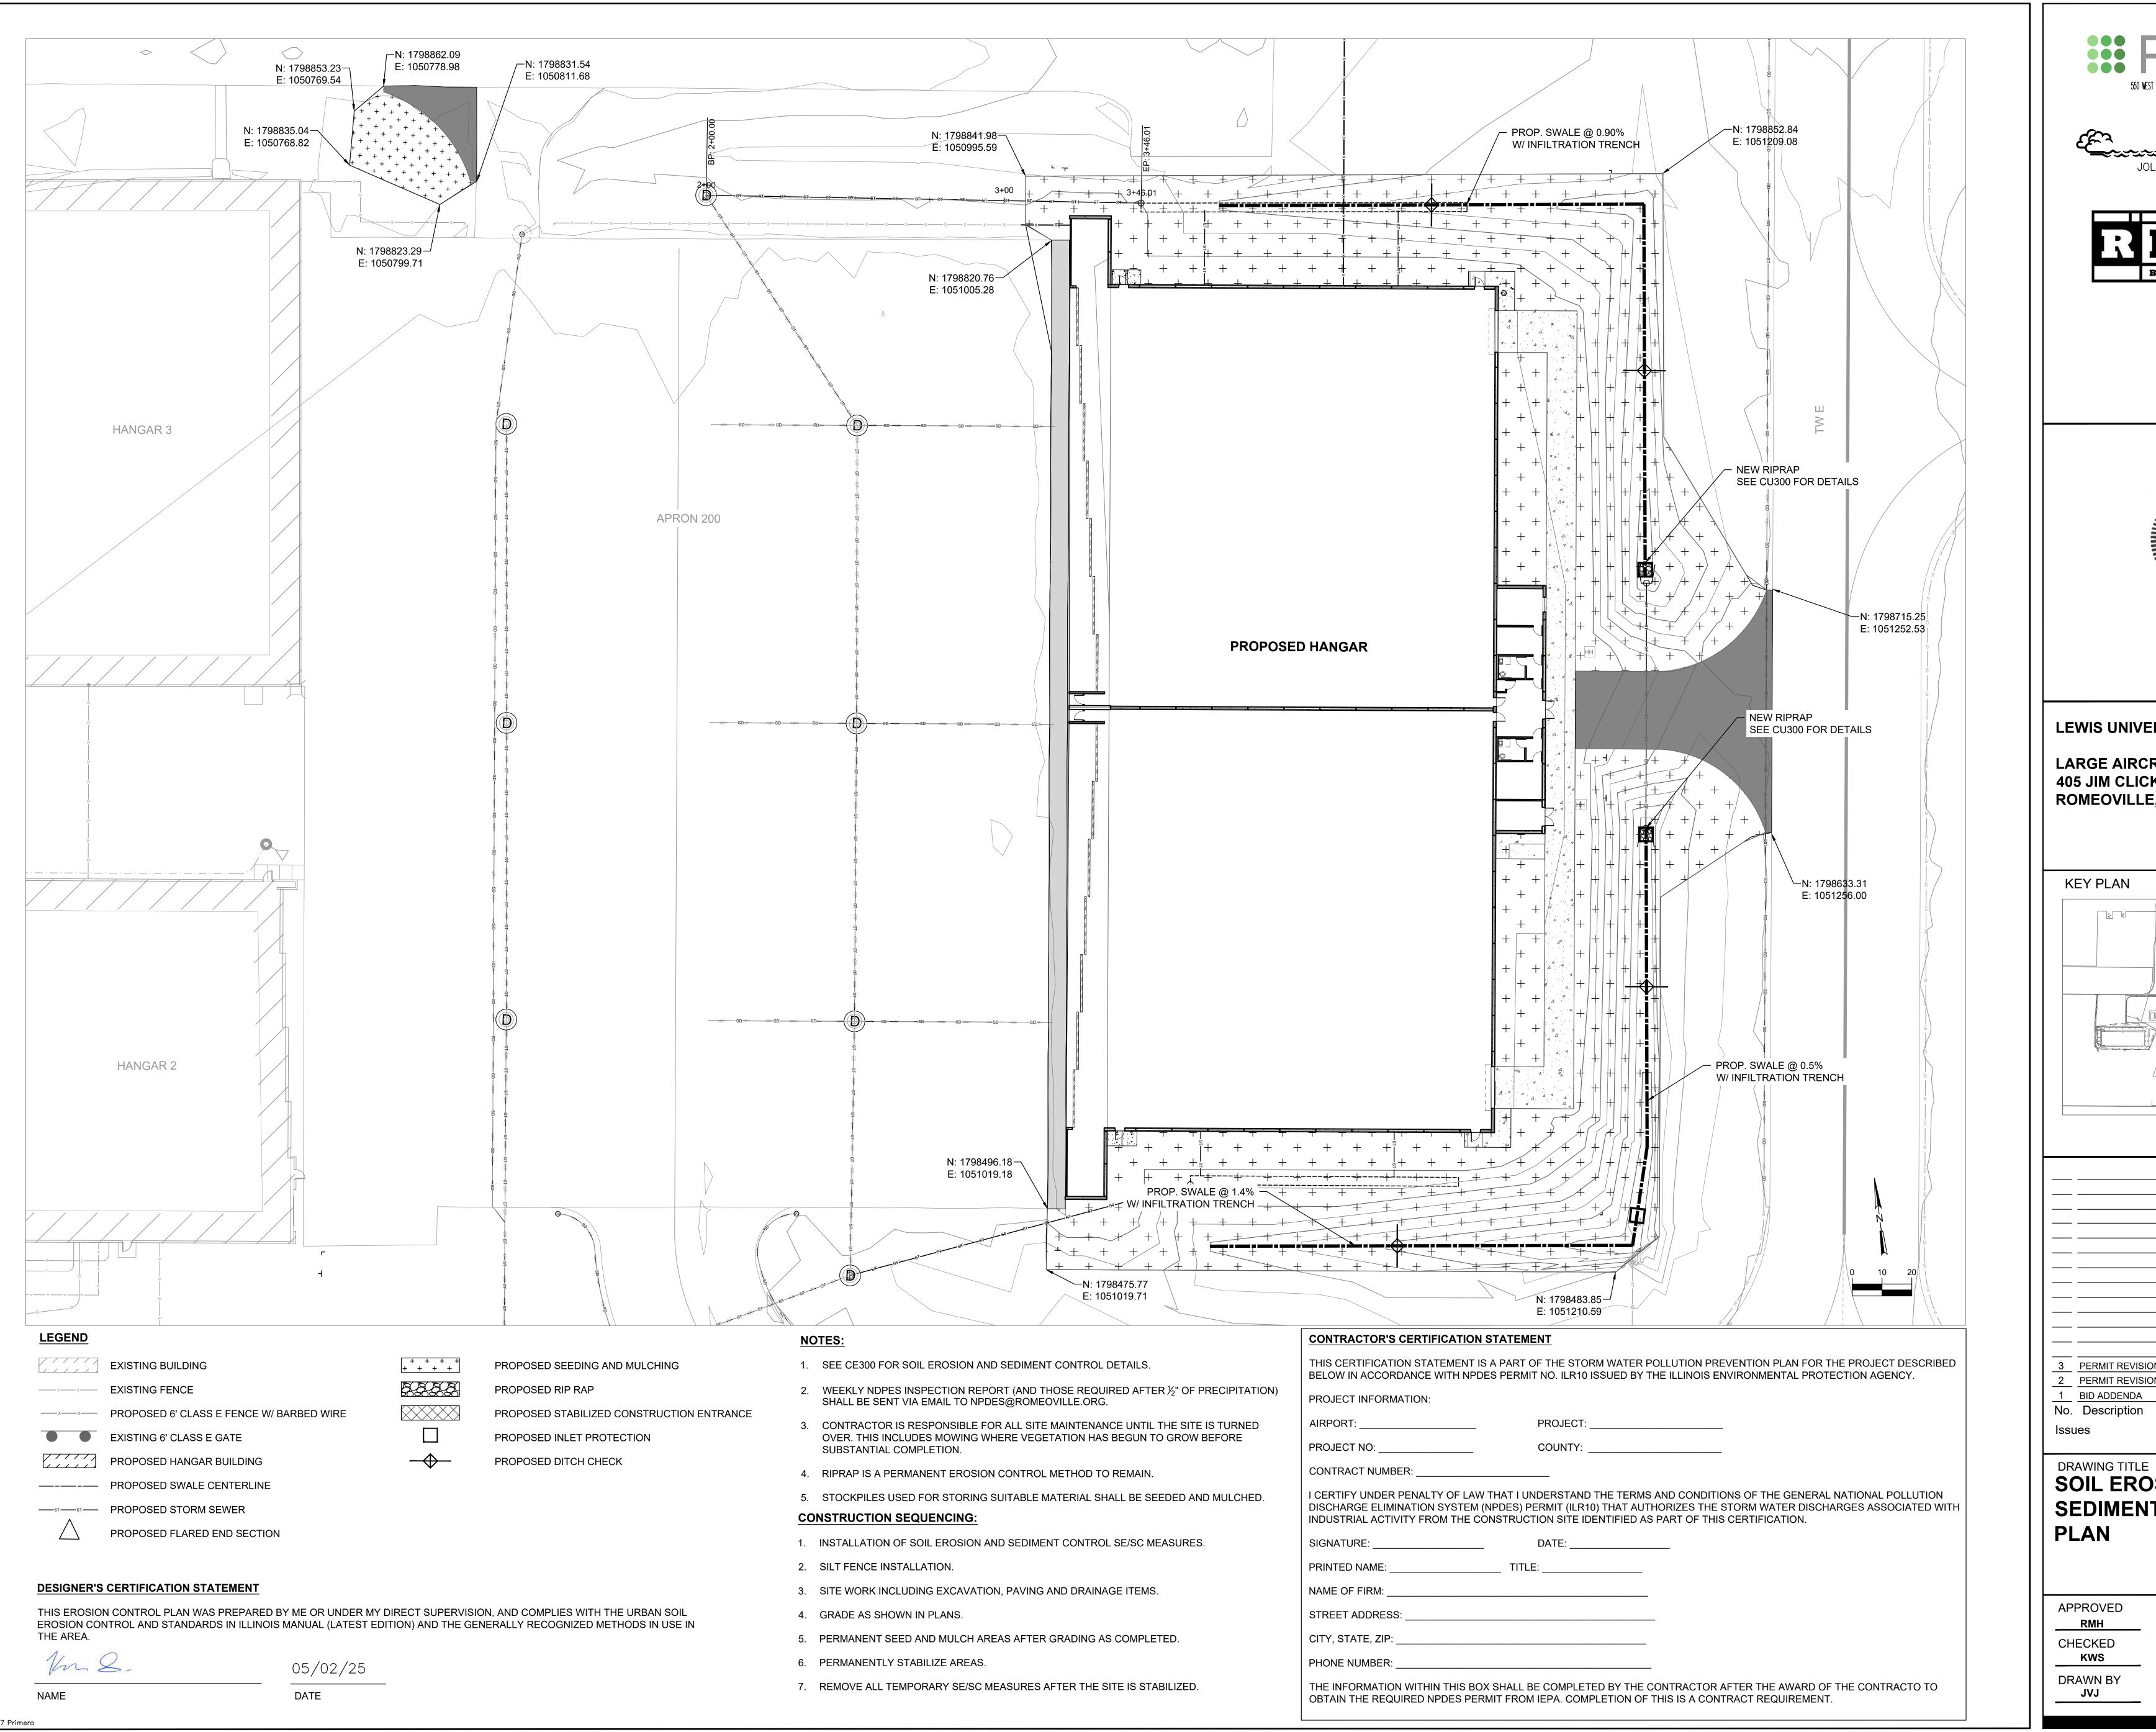






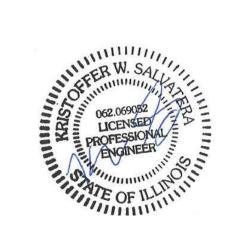

LARGE AIRCRAFT STORAGE HANGAR 405 JIM CLICK DRIVE ROMEOVILLE, ILLINOIS

KEY PLAN

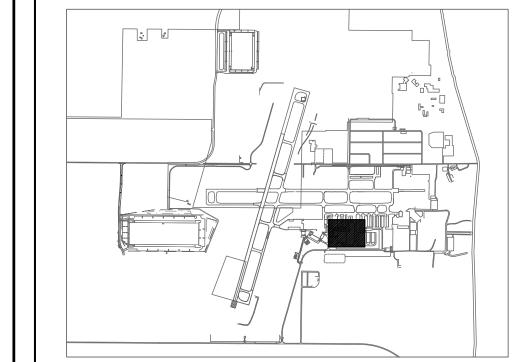

| | | | | | - |
|------|------------------|----|------|-----|----------|
| | | | | | |
| | | | | | |
| | | | | | |
| 3 | PERMIT REVISIONS | | | | 06/06/25 |
| 2 | PERMIT REVISIONS | | | | 05/02/25 |
| 1 | BID ADDENDA | | | | 05/02/25 |
| No. | Description | By | Chk. | App | . Date |
| Issu | ISS. | | | | |
| 1330 | 103 | | | | |
| | | | | | |

SOIL EROSION AND

SEDIMENT CONTROL **PLAN**

| APPROVED | | | |
|----------|--|--|--|
| RMH | | | |
| OUEOVED | | | |

SHEET NO.


CHECKED

CE100

DRAWN BY JVJ


SEDIMENTATION AND EROSION CONTROL NOTES:

- A. UNLESS OTHERWISE INDICATED, ALL VEGETATIVE AND STRUCTURAL EROSION AND SEDIMENT CONTROL PRACTICES WILL BE CONSTRUCTED ACCORDING TO MINIMUM STANDARDS AND SPECIFICATIONS IN THE ILLINOIS URBAN MANUAL'S LATEST EDITION.
- B. AN UP-TO-DATE COPY OF THE APPROVED EROSION AND SEDIMENT CONTROL PLAN SHALL BE MAINTAINED ON THE SITE AT ALL
- C. IT IS THE RESPONSIBILITY OF THE LANDOWNER AND/OR GENERAL CONTRACTOR TO INFORM ANY SUB-CONTRACTOR(S) WHO MAY PERFORM WORK ON THIS PROJECT, OF THE REQUIREMENTS IN IMPLEMENTING AND MAINTAINING THESE EROSION CONTROL PLANS AND ASSURE COMPLIANCE WITH ALL APPLICABLE LOCAL, STATE, AND FEDERAL REGULATIONS.
- D. SOIL DISTURBANCE SHALL BE CONDUCTED IN SUCH A MANNER AS TO MINIMIZE EROSION. SOIL STABILIZATION MEASURES SHALL CONSIDER THE TIME OF YEAR, SITE CONDITIONS AND THE USE OF TEMPORARY OR PERMANENT MEASURES.
- E. SOIL EROSION AND SEDIMENT CONTROL FEATURES SHALL BE CONSTRUCTED PRIOR TO THE COMMENCEMENT OF HYDROLOGIC DISTURBANCE OF UPLAND AREAS.
- F. DISTURBED AREAS SHALL BE STABILIZED WITH TEMPORARY OR PERMANENT MEASURES WITHIN 14 CALENDAR DAYS OF THE END OF ACTIVE HYDROLOGIC DISTURBANCE, OR REDISTURBANCE.
- G. AREAS OR EMBANKMENTS HAVING SLOPES GREATER THAN OR EQUAL TO 8H:1V SHALL BE STABILIZED WITH SOD, MAT OR BLANKET IN COMBINATION WITH SEEDING.
- H. ALL STORM SEWERS THAT ARE OR WILL BE FUNCTIONING DURING CONSTRUCTION SHALL BE PROTECTED, BY AN APPROPRIATE SEDIMENT CONTROL MEASURE.
- I. ALL TEMPORARY EROSION AND SEDIMENT CONTROL MEASURES SHALL BE REMOVED WITHIN 30 DAYS AFTER FINAL SITE STABILIZATION IS ACHIEVED OR AFTER THE TEMPORARY MEASURES ARE NO LONGER NEEDED.
- J. ALL TEMPORARY AND PERMANENT EROSION CONTROL MEASURES MUST BE MAINTAINED AND REPAIRED AS NEEDED. THE PROPERTY OWNER SHALL BE ULTIMATELY RESPONSIBLE FOR MAINTENANCE AND REPAIR.
- K. SOIL STOCKPILES SHALL NOT BE LOCATED IN A FLOOD PRONE AREA OR A DESIGNATED BUFFER. NO STOCKPILES SHALL BE LOCATED WITHIN AN ACTIVE RUNWAY SAFETY AREA, RUNWAY OBJECT FREE AREA, RUNWAY OBSTACLE FREE ZONE, OR ACTIVE TAXIWAY OBJECT FREE AREA.
- L. ALL ACCESS TO AND FROM THE CONSTRUCTION SITE IS TO BE RESTRICTED TO THE CONSTRUCTION ENTRANCE.
- M. ALL TEMPORARY AND PERMANENT EROSION AND SEDIMENT CONTROL PRACTICES MUST BE MAINTAINED AND REPAIRED AS NEEDED TO ASSURE EFFECTIVE PERFORMANCE OF THEIR INTENDED FUNCTION.
- N. MAJOR AMENDMENTS OF THE SITE DEVELOPMENT OR EROSION AND SEDIMENTATION CONTROL PLANS SHALL BE SUBMITTED TO THE DEPARTMENT OF COMMUNITY DEVELOPMENT TO BE APPROVED IN THE SAME MANNER AS THE ORIGINAL PLANS.
- O. ANY SEDIMENT REACHING A PUBLIC OR PRIVATE ROAD SHALL BE REMOVED BY SHOVELING OR STREET CLEANING (NOT FLUSHING) BEFORE THE END OF EACH WORKDAY AND TRANSPORTED TO A CONTROLLED SEDIMENT DISPOSAL.
- P. ALL TEMPORARY EROSION AND SEDIMENT CONTROL MEASURES SHALL BE DISPOSED OF WITHIN 30 DAYS AFTER THE FINAL SITE STABILIZATION IS ACHIEVED WITH PERMANENT SOIL STABILIZATION MEASURES.
- Q. DISTURBED AREAS SHALL BE STABILIZED WITH TEMPORARY OR PERMANENT MEASURES WITHIN 7 CALENDAR DAYS FOLLOWING THE END OF ACTIVE DISTURBANCE OR REDISTURBANCE.
- R. IF DEWATERING DEVICES ARE USED, DISCHARGE LOCATIONS SHALL BE PROTECTED FROM EROSION. ALL PUMPED DISCHARGES SHALL BE ROUTED THROUGH APPROPRIATELY DESIGNED SEDIMENT TRAPS OR BASINS.

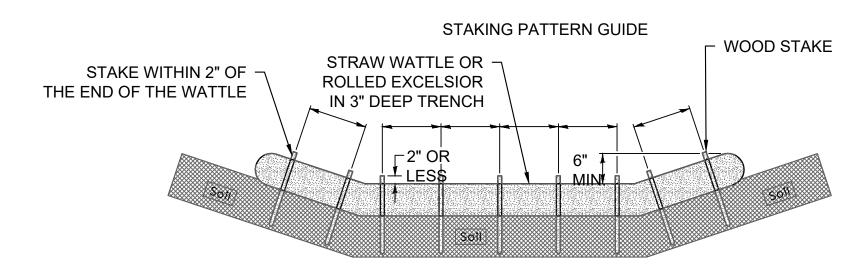


NOTES:

- 1. OVERLAP MINIMUM IS THE DIAMETER OF THE ROLL.
- 2. 4' SPACING FOR WATTLES.
- 3. 2' SPACING FOR ROLLED EXCELSIOR. 4. OR SPACE ACCORDING TO MANUFACTURER'S SPECIFICATIONS.

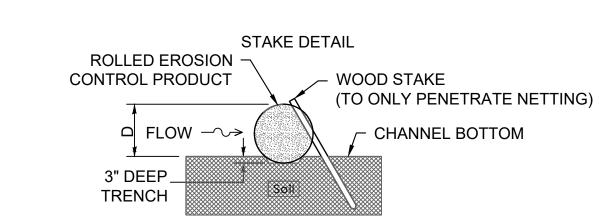


- DRAWINGS ARE NOT TO SCALE.
- 2. ENDS OF WATTLES OR ROLLED EXCELSIOR SHALL BE TURNED AT LEAST
- 6" UPLSLOPE. 3. RECOMMENDED STAKES ARE $1\frac{1}{8}$ " WIDE X $1\frac{1}{8}$ " THICK X 30" LONG.
- 4. STAKES SHALL NOT EXTEND ABOVE THE STRAW WATTLE MORE THAN 2'
- 5. SPACING: THE TOES OF THE UPSTREAM DITCH CHECK SHALL CREATE A HORIZONTAL LINE WITH THE TOP OF THE DOWNSTREAM CHECK

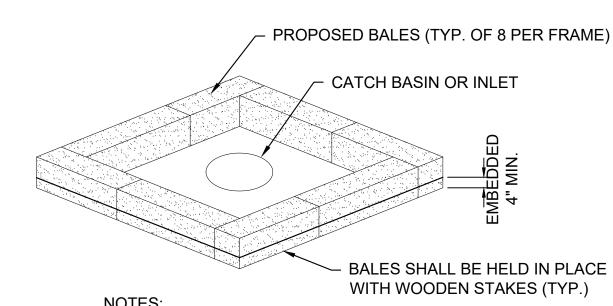

1. CONTRACTOR TO INSTALL, MAINTAIN, REMOVE AND RESTORE EACH LOCATION.


2. COST OF INLET/CATCH BASIN PROTECTION AND RESTORATION SHALL BE CONSIDERED INCIDENTAL TO BE COST OF THE ASSOCIATED DRAINAGE STRUCTURE

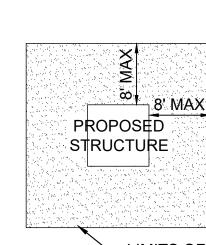

- LIMITS OF EXCELSIOR **BLANKET (TO BE INSERTED** AFTER BALES REMOVED)

INLET PROTECTION

DITCH CHECK

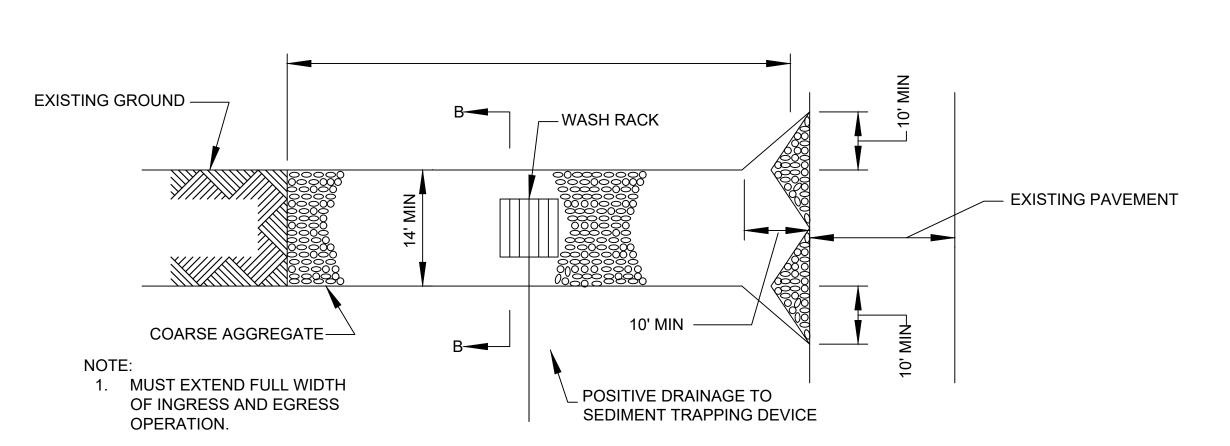

- 5:1 SLOPE **EXISTING PAVEMENT**

MOUNTABLE BERM (OPTIONAL) EXISTING GROUND STABILIZED CONSTRUCTION ENTRANCE PROFILE


STABILIZED CONSTRUCTION ENTRANCE PLAN

1. FILTER FABRIC SHALL MEET THE REQUIREMENTS OF MATERIAL SPECIFICATION 592 GEOTEXTILE, TABLE 1 OR 2, CLASS I, II, OR IV AND SHALL BE PLACED OVER THE CLEARED AREA PRIOR TO THE PLACING OF ROCK.


2. ROCK OR RECLAIMED CONCRETE SHALL MEET ONE OF THE FOLLOWING IDOT COARSE AGGREGATE GRADATION, CA-1, CA-2, CA-3, OR CA-4 AND BE PLACED ACCORDING TO CONSTRUCTION SPECIFICATION 25

N.T.S

- ROCKFILL USING PLACEMENT METHOD 1 AND CLASS III COMPACTION. 3. ANY DRAINAGE FACILITIES REQUIRED BECAUSE OF WASHING SHALL BE CONSTRUCTED ACCORDING TO MANUFACTURERS SPECIFICATIONS.
- 4. IF WASH RACKS ARE USED THEY SHALL BE INSTALLED ACCORDING TO THE MANUFACTURER'S
- SPECIFICATIONS.

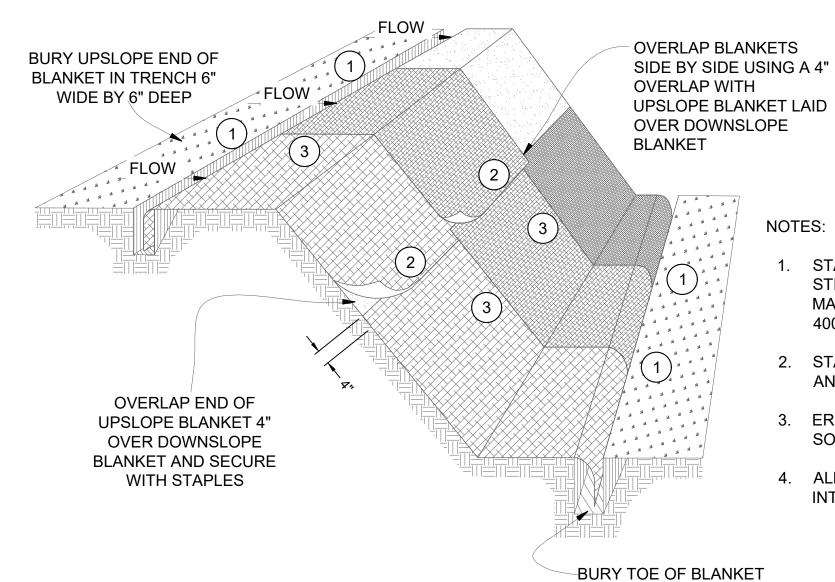

- STAPLES SHALL BE PLACED IN A DIAMOND PATTERN AT 2 PER S.Y. FOR STITCHED BLANKETS. NON-STITCHED SHALL USE 4 STAPLES PER S.Y. OF MATERIAL. THIS EQUATES TO 200 STAPLES WITH STITCHED BLANKET AND 400 STAPLES WITH NON-STITCHED BLANKET PER 100 S.Y. OF MATERIAL
- STAPLE OF PUSH PIN LENGTHS SHALL BE SELECTED BASED ON SOIL TYPE AND CONDITIONS. (MINIMUM STAPLE LENGTH IS 6").
- EROSION CONTROL MATERIAL SHALL BE PLACED IN CONTACT WITH THE SOIL OVER A PREPARED SEEDBED.
- 4. ALL ANCHOR SLOTS SHALL BE STAPLED AT APPROXIMATELY 12" INTERVALS.

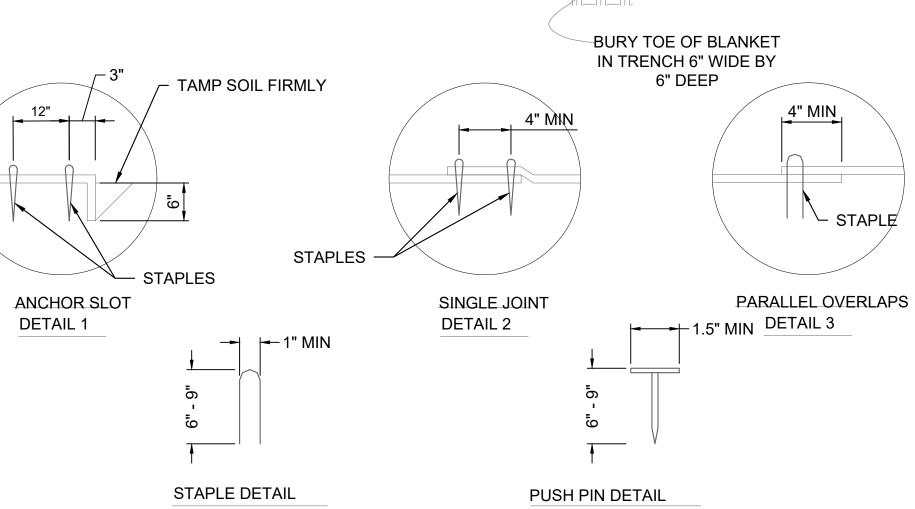

EROSION CONTROL BLANKET INSTALLATION DETAILS N.T.S

550 WEST JACKSON BLVD., SUITE 600, CHICAGO, ILLINOIS 60661







LEWIS UNIVERSITY AIRPORT

LARGE AIRCRAFT STORAGE HANGAR **405 JIM CLICK DRIVE** ROMEOVILLE, ILLINOIS

PERMIT REVISIONS PERMIT REVISIONS BID ADDENDA

DRAWING TITLE SOIL EROSION AND SEDIMENT CONTROL **NOTES AND DETAILS**

APPROVED CHECKED

No. Description


Issues

SHEET NO.

By Chk. App. Date

CE300

DRAWN BY

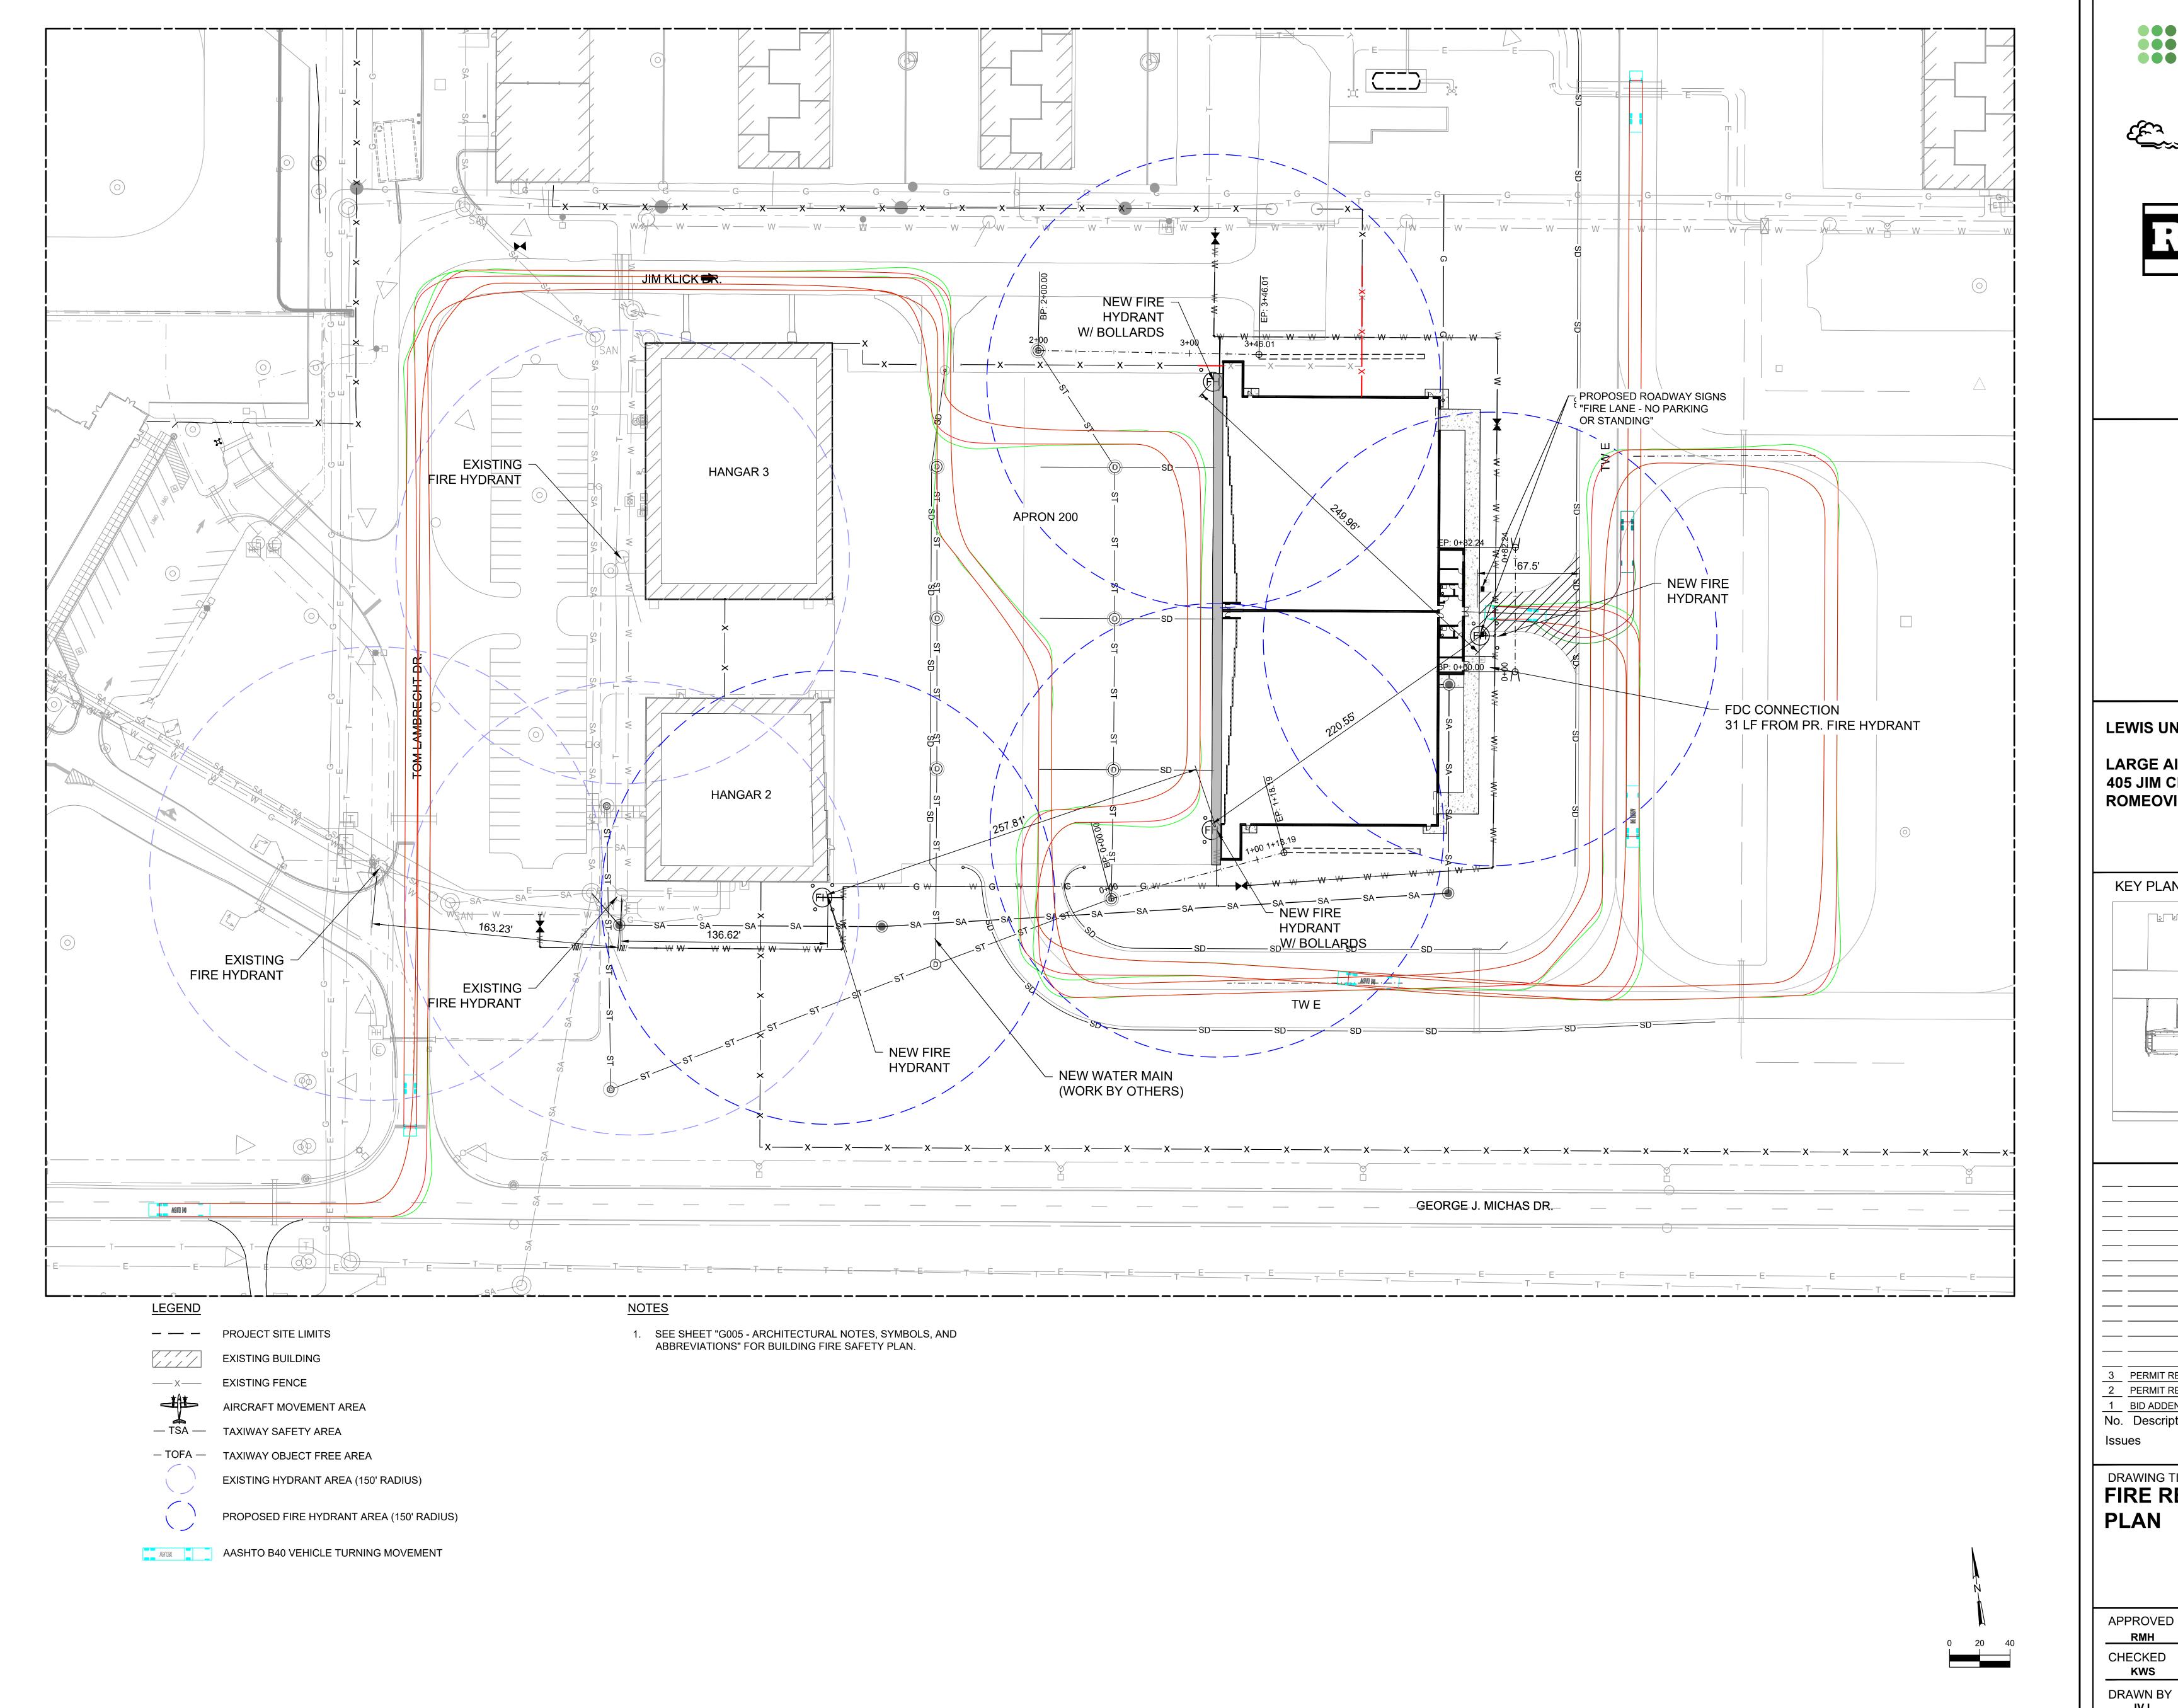










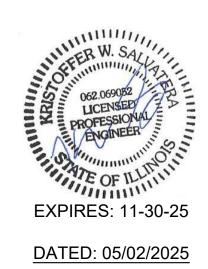

LEWIS UNIVERSITY AIRPORT

LARGE AIRCRAFT STORAGE HANGAR **405 JIM CLICK DRIVE** ROMEOVILLE, ILLINOIS

KEY PLAN

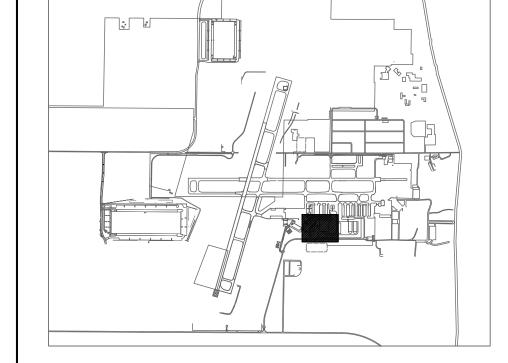


| _ | | | | | | |
|-------|------------------|----|------|-----|----------|--|
| | | | | | | |
| _ | | | | | | |
| | | | | | | |
| | | | | | | |
| 3 | PERMIT REVISIONS | | | | 06/06/25 | |
| 2 | PERMIT REVISIONS | | | | 05/02/25 | |
| 1 | BID ADDENDA | | | | 05/02/25 | |
| lo. | Description | By | Chk. | App | Date | |
| ssues | | | | | | |
| 33U | | | | | | |
| | | | | | | |

DRAWING TITLE **FIRE RESPONSE** PLAN


APPROVED CHECKED

SHEET NO.

CF100

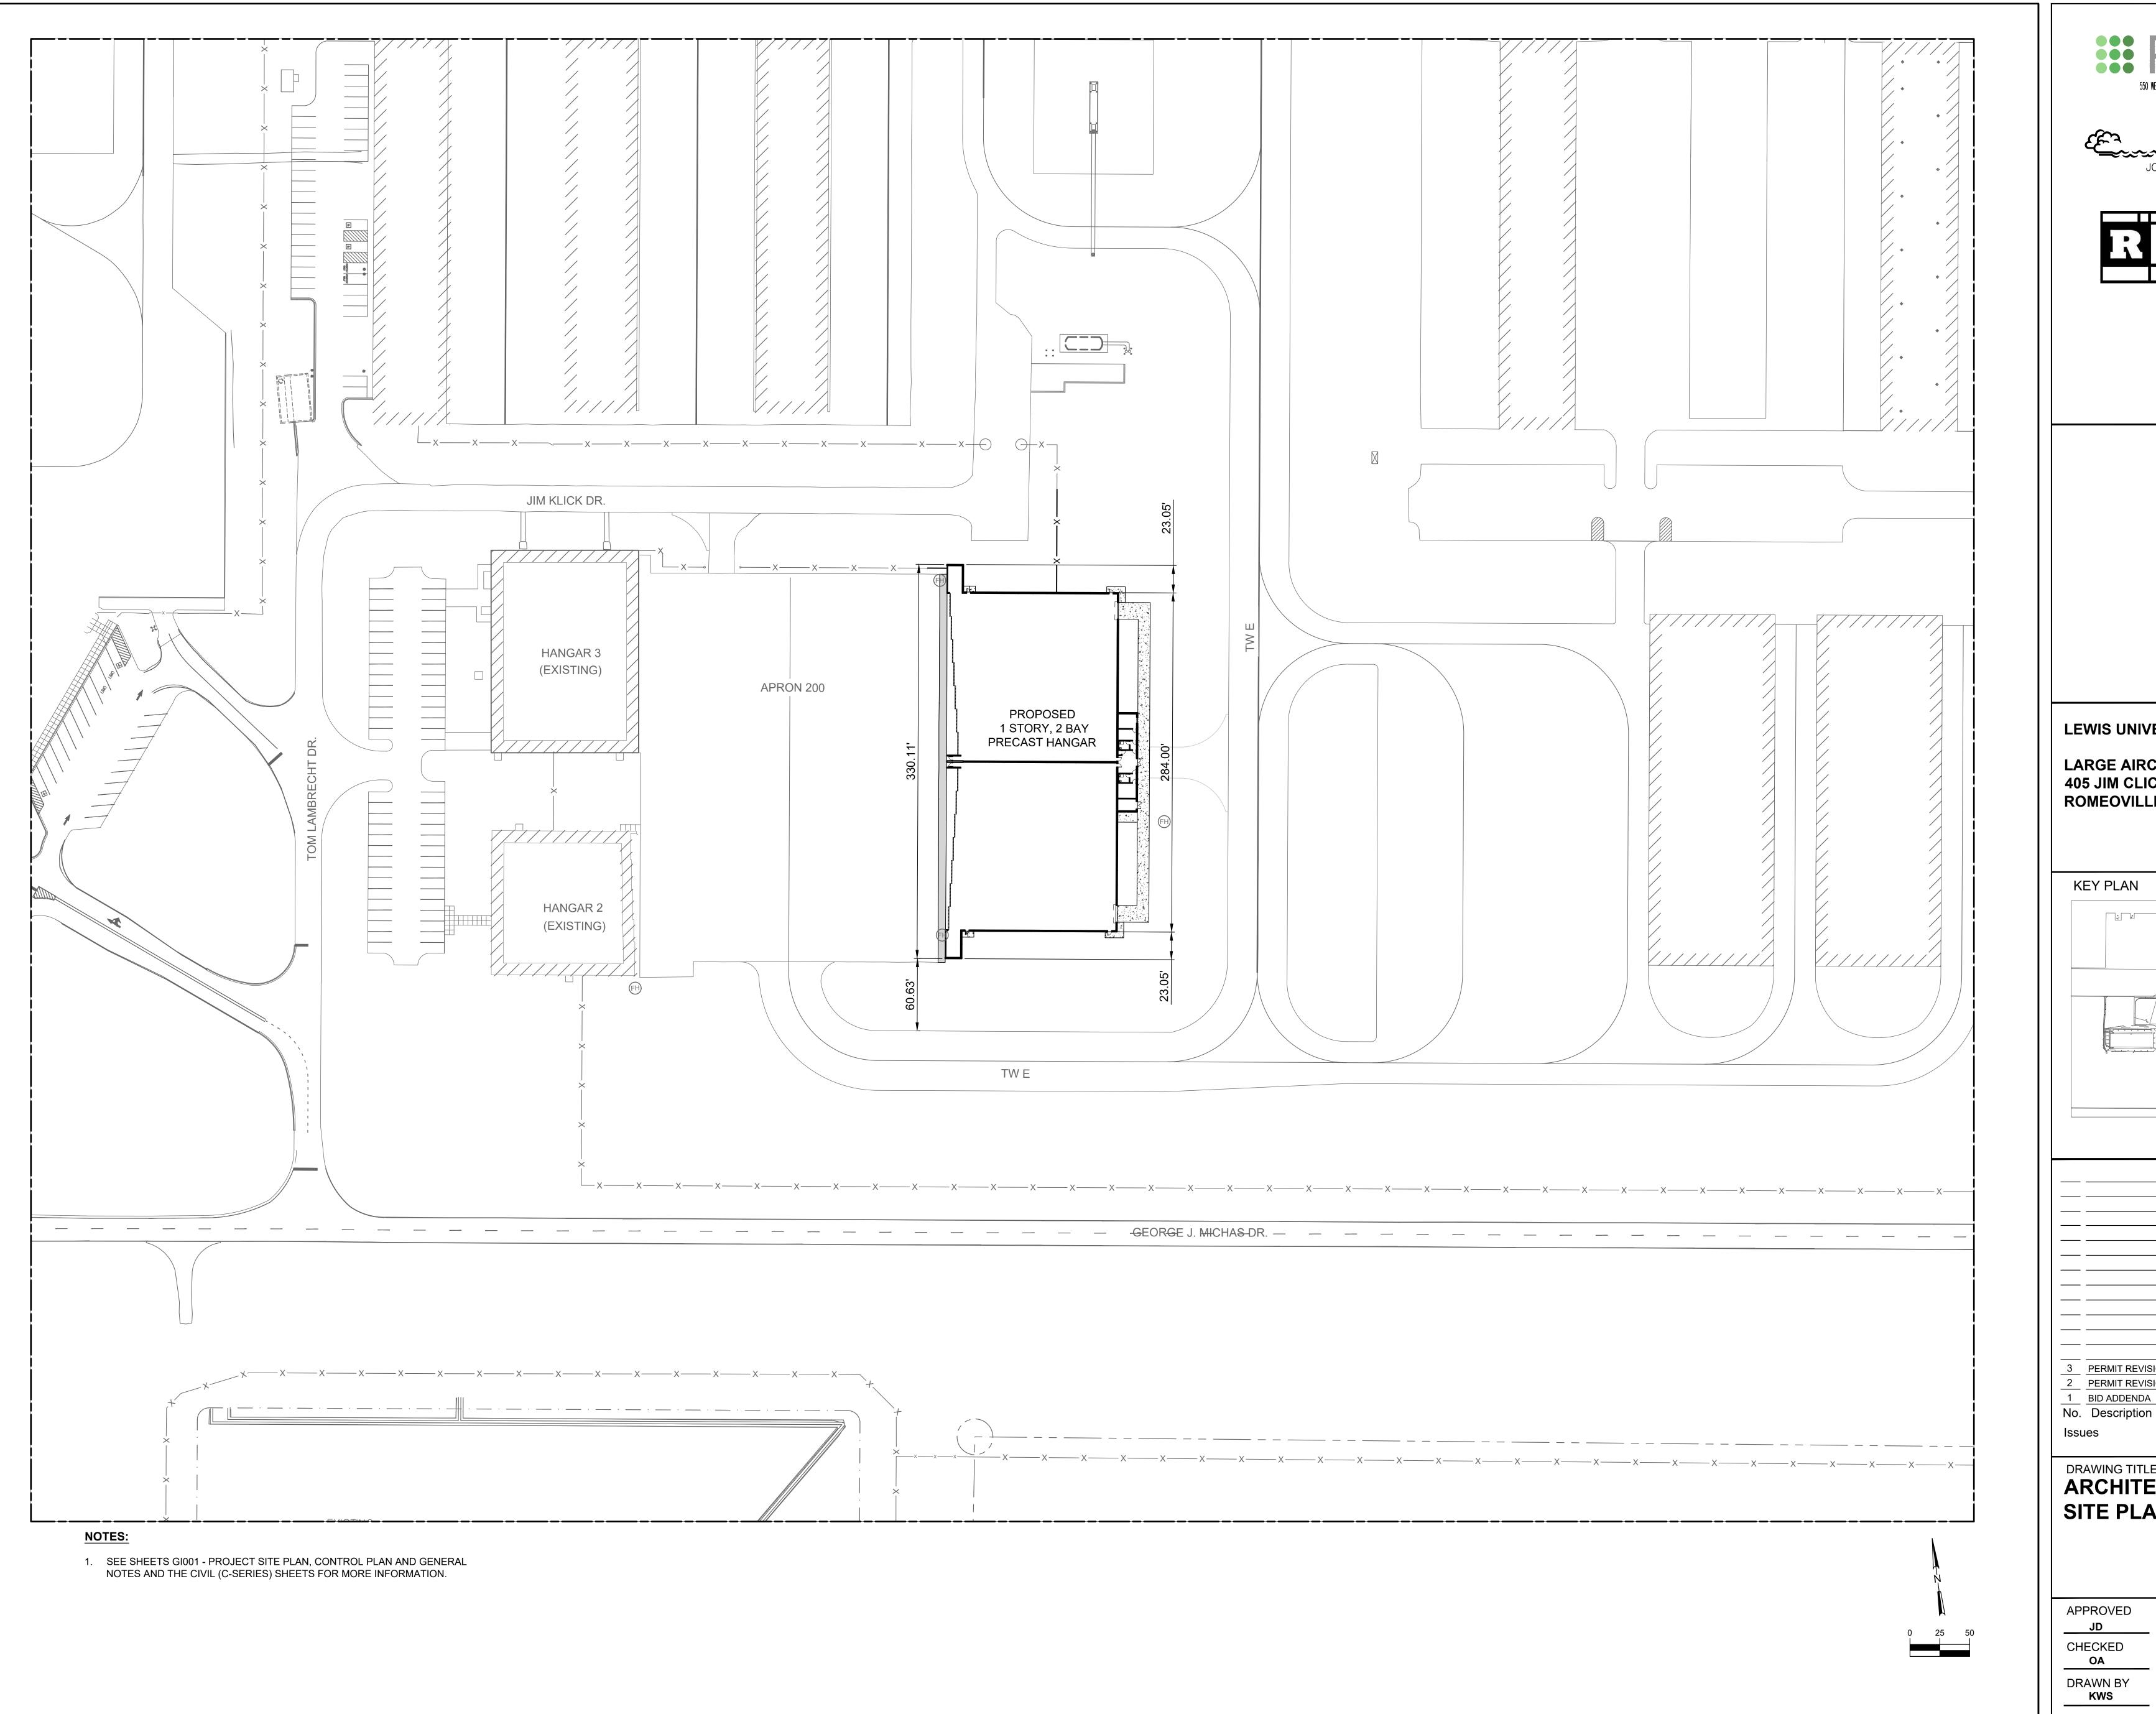




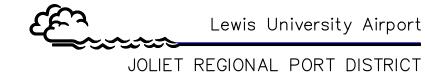



LARGE AIRCRAFT STORAGE HANGAR **405 JIM CLICK DRIVE** ROMEOVILLE, ILLINOIS

KEY PLAN

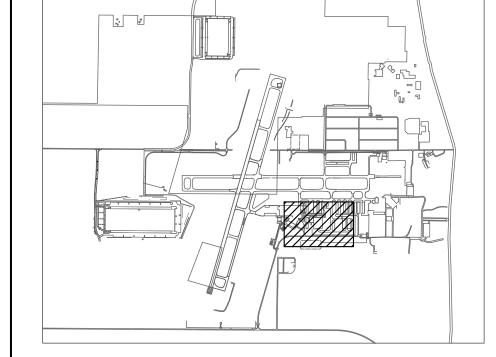

| PERMIT REVISIONS | 06/06/25 |
|------------------|-------------------|
| PERMIT REVISIONS | 05/02/25 |
| BID ADDENDA | 05/02/25 |
| Description | By Chk. App. Date |

ARCHITECTURAL

SITE PLAN

APPROVED

SHEET NO.

A100